


34 32 30 28 26 24 22 20 18 16 14 12 10 8 6 4 2 0

PDWMS 03065 450 36X 323389


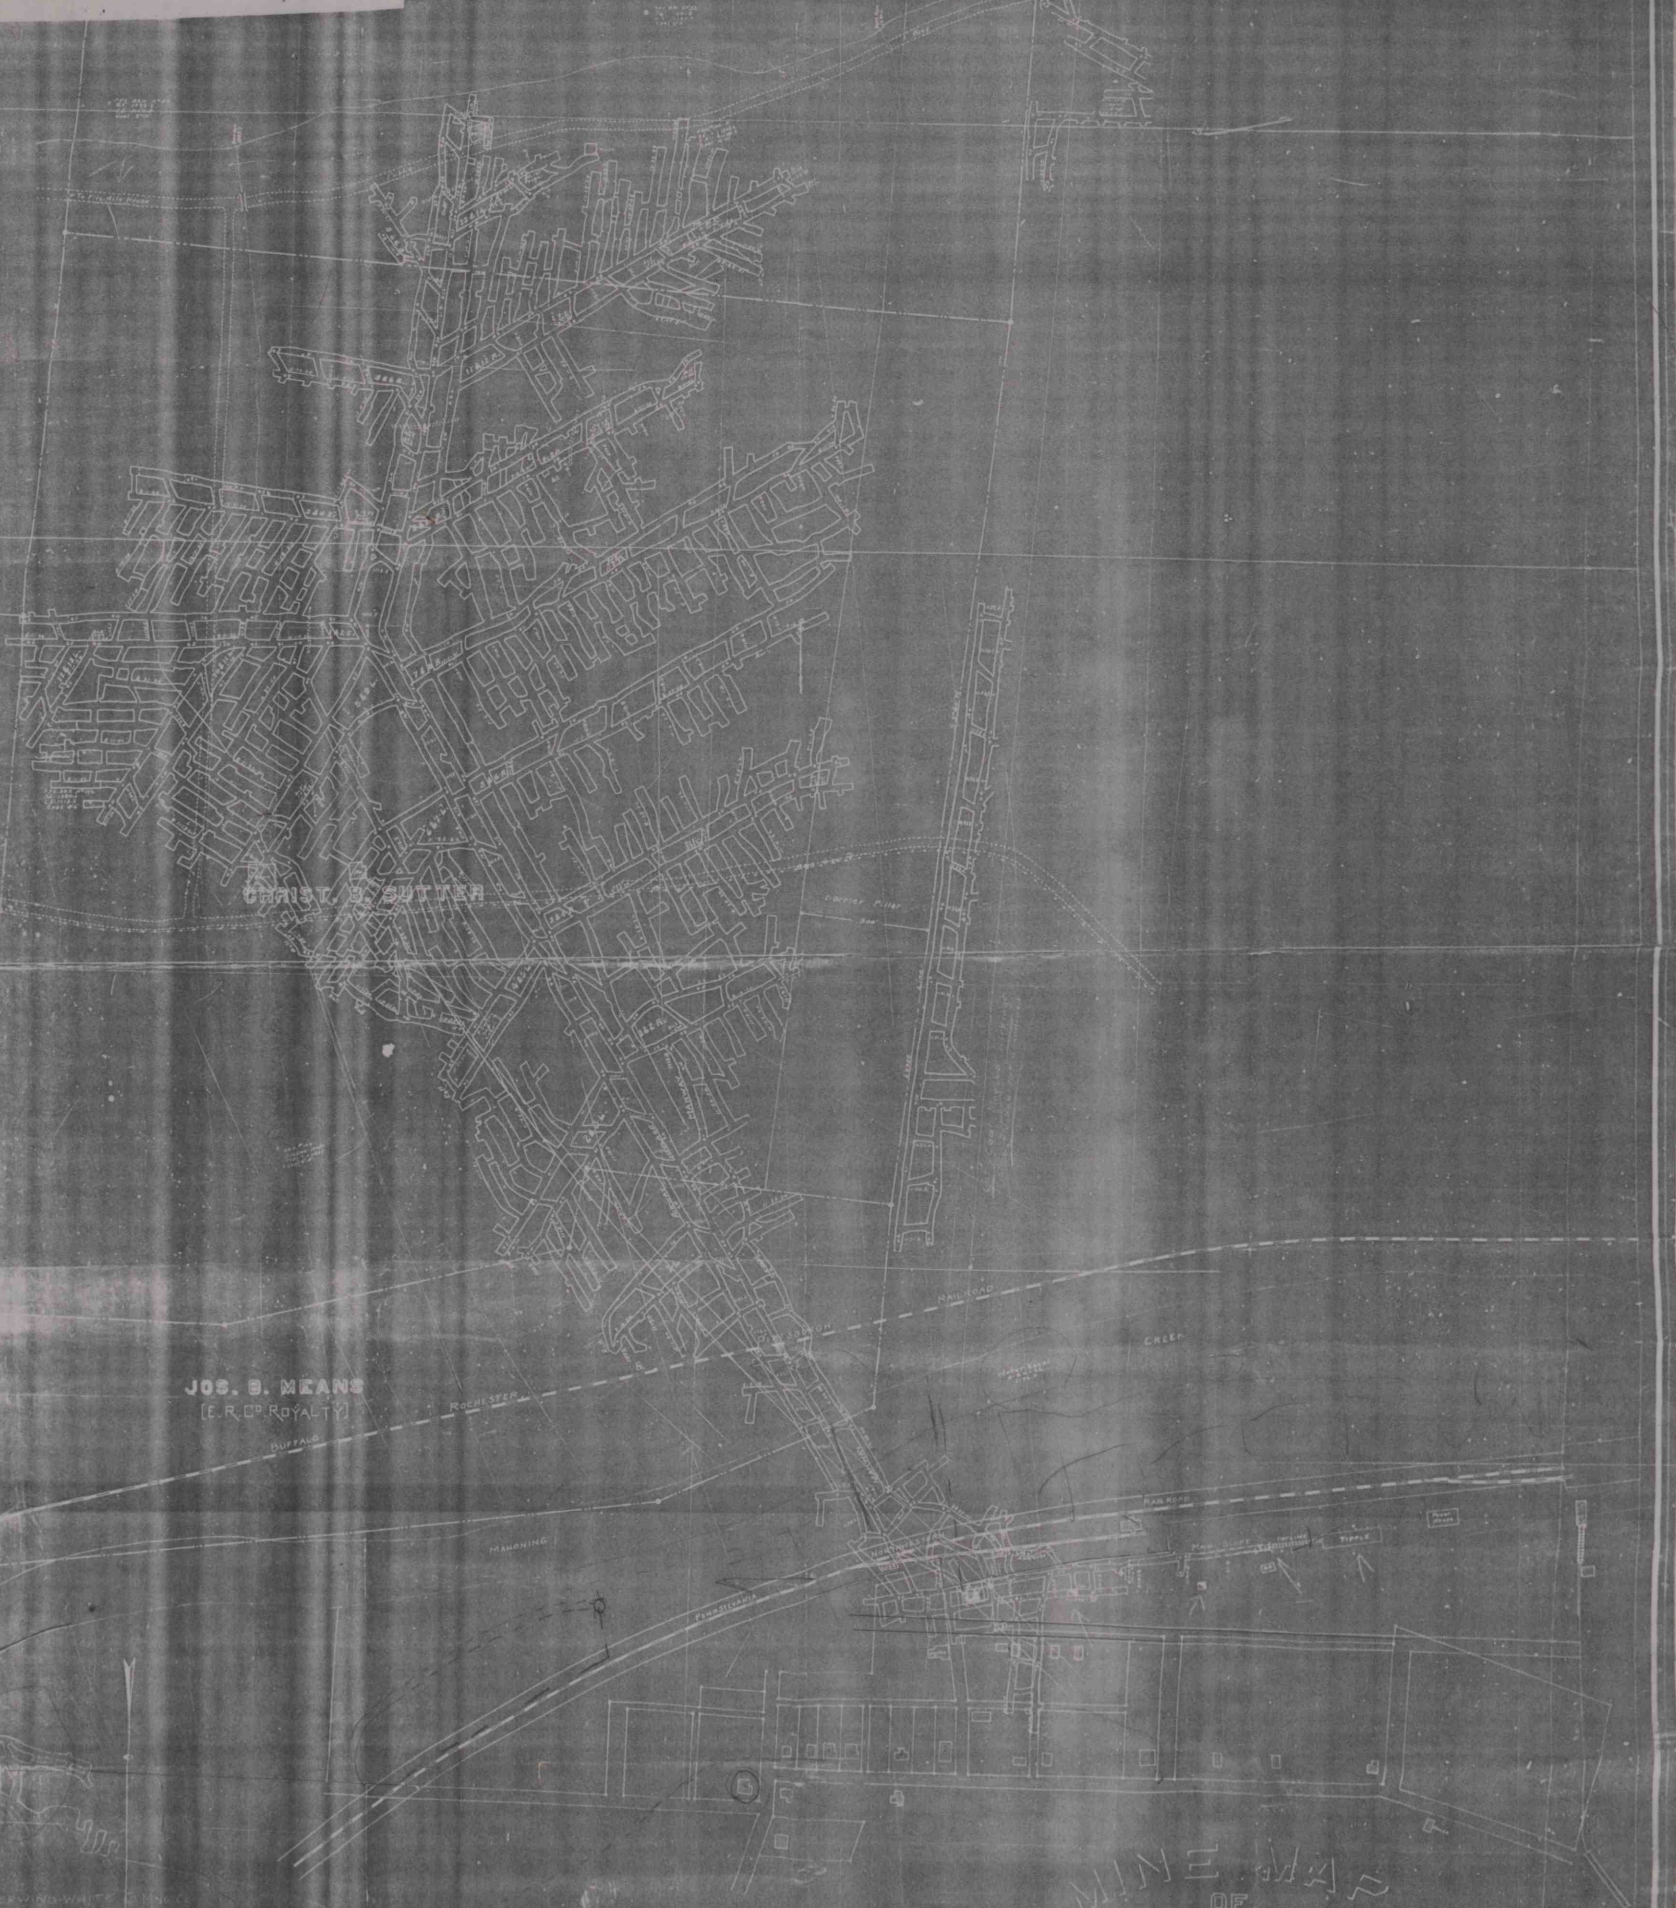


JOS. B. MEANS
[E.R. CO. ROYALTY]

CHRIST. S. SUTTER

DATE OF LAST SURVEY

Nov. 2, 1908
June 3, 1909
Sept. 8, 1909
May 1, 1910
July 4, 1912
June 14, 1924
Dec. 12, 1929
Nov. 10, 1931
Mar. 25, 1937
Aug. 8, 1938
Jan. 1, 1940
Dec. 31, 1940

MINE MAP
OF
THE VEGA MINE
BULAH SHAFT COAL CO.
VALIER, PA.

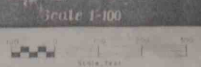

The H.M. Cameron Co.
Mining Engineers
Pittsburgh, Pa.