


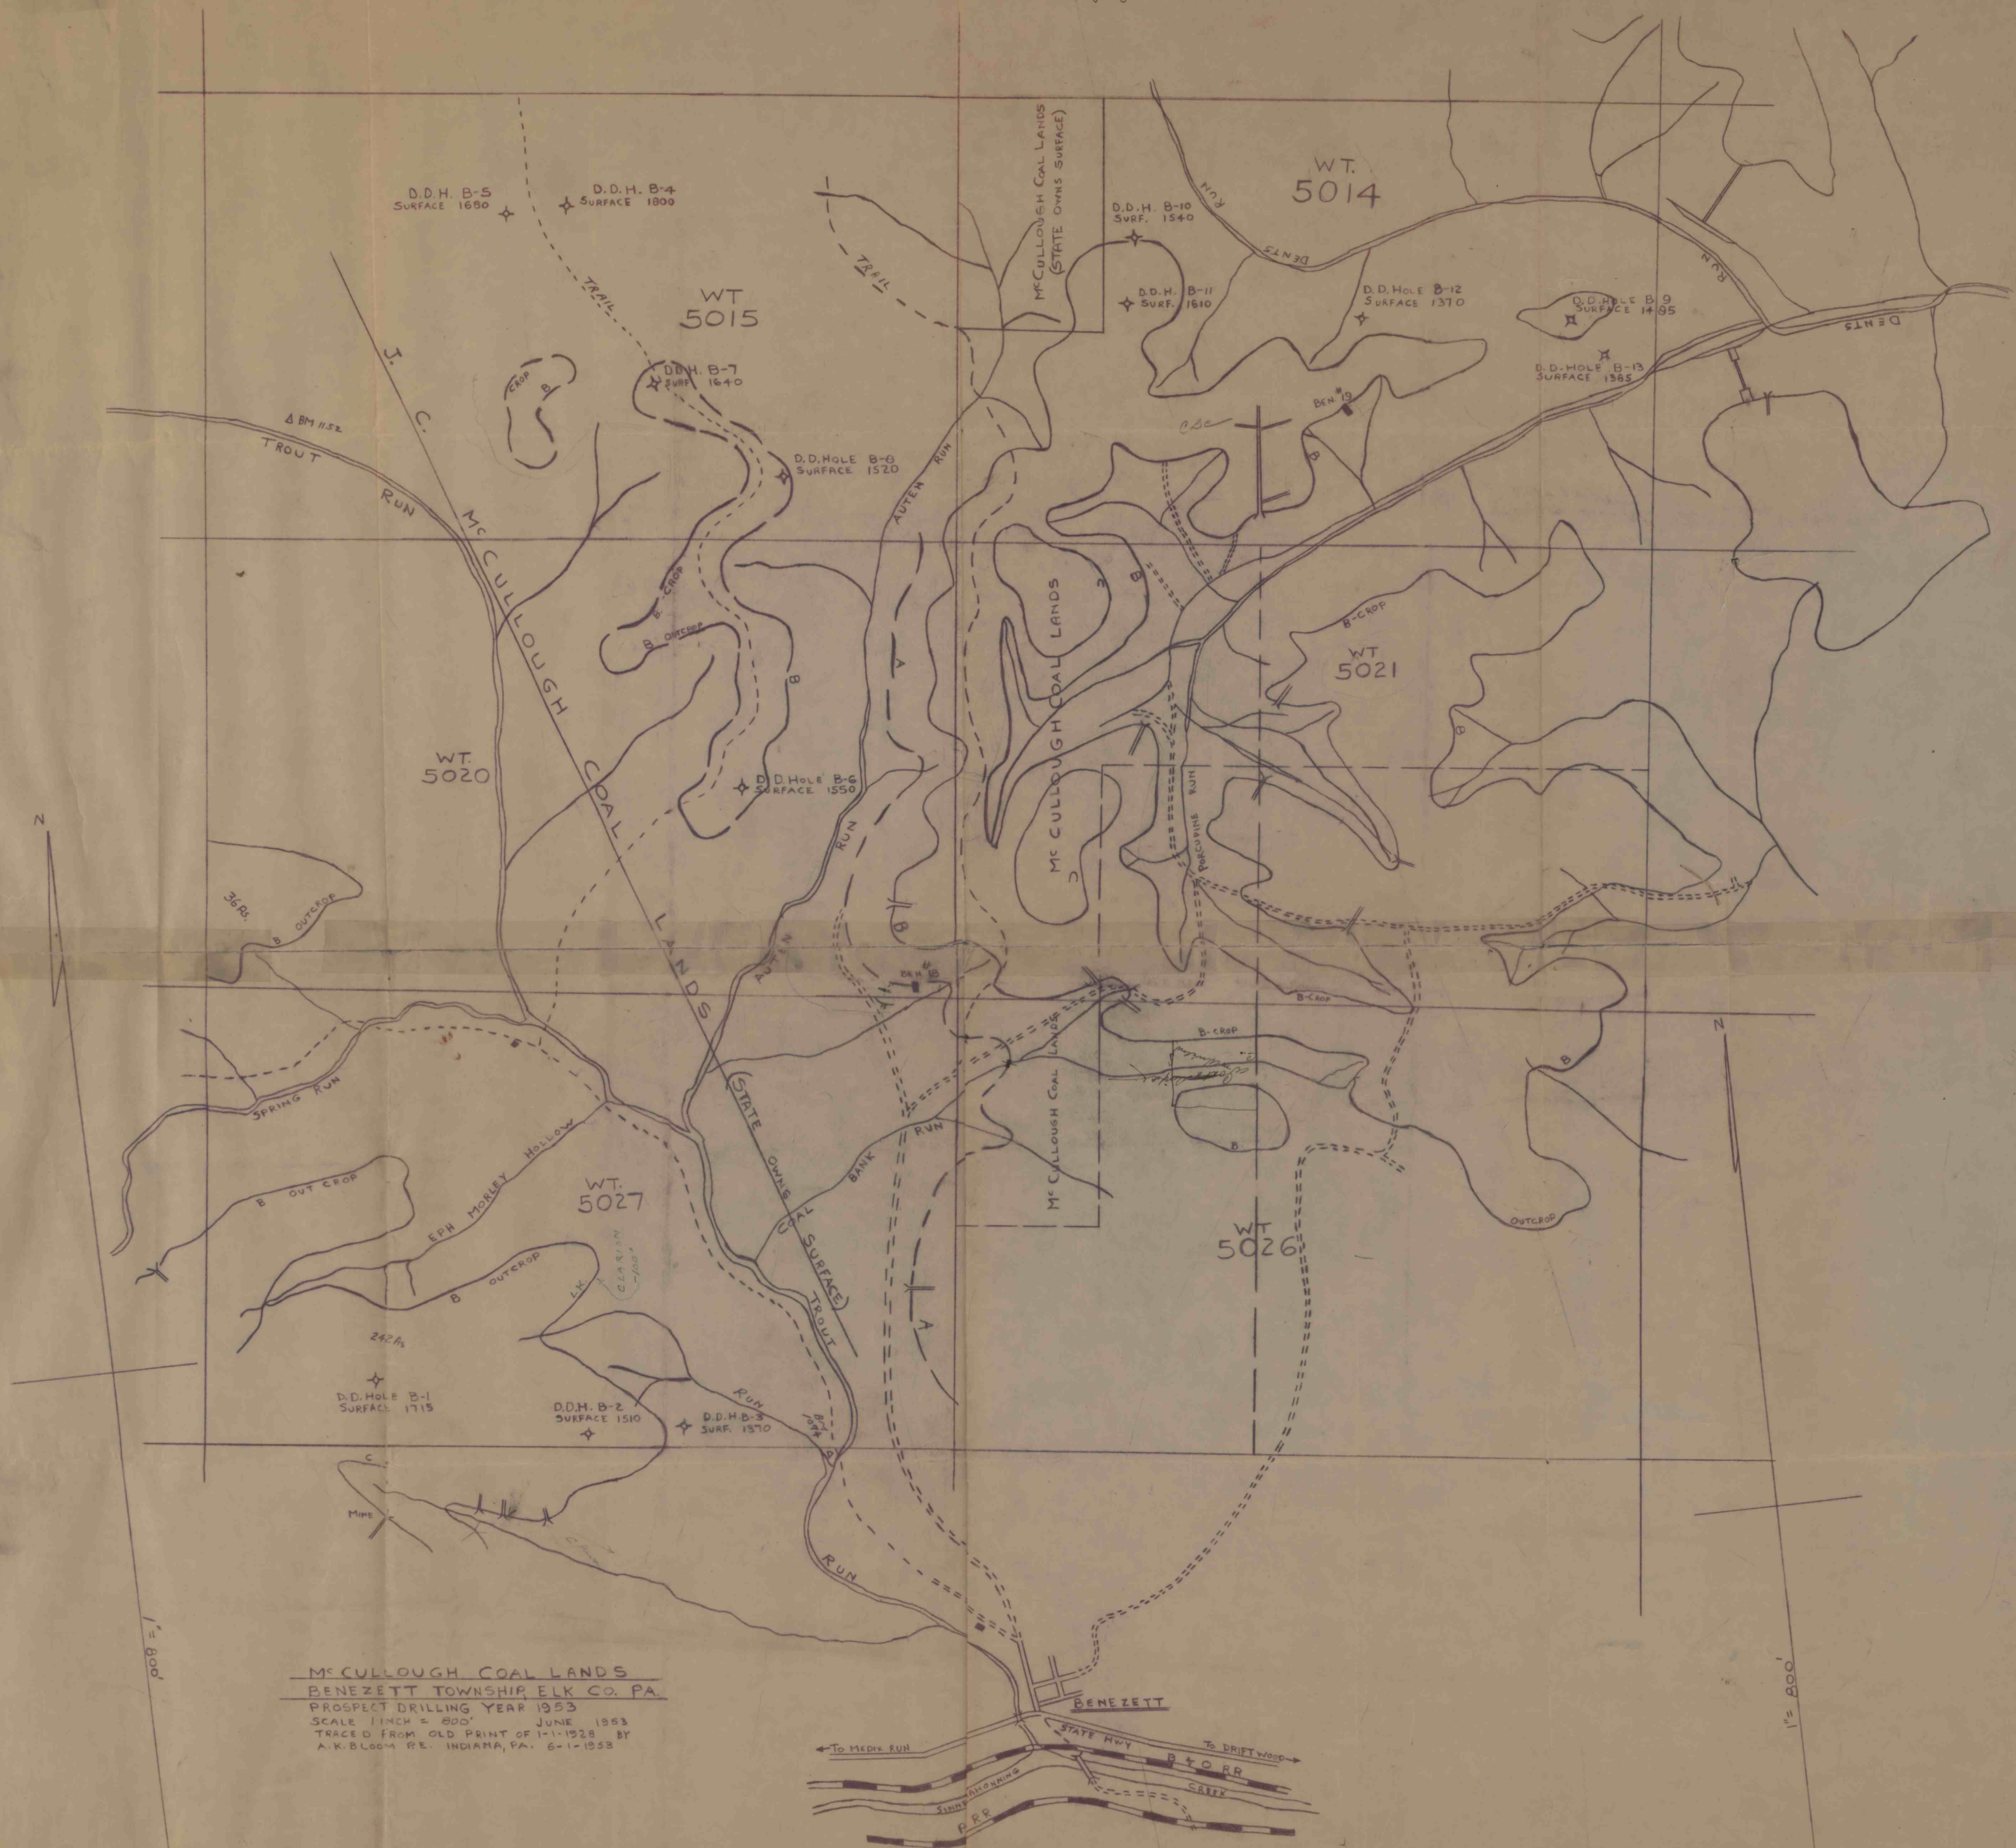

McCULLOUGH COAL LANDS
BENZETT TOWNSHIP, ELK CO., PA.
PROSPECT DRILLING YEAR 1953
SCALE 1 INCH = 800' JUNE 1953
TRACE FROM OLD PRINT OF 1-1-1928 BY
A.K. BLOOM RE. INDIANA, PA. 6-1-1953