


DIAMOND DRILL OPERATION - DILL HILL AREA

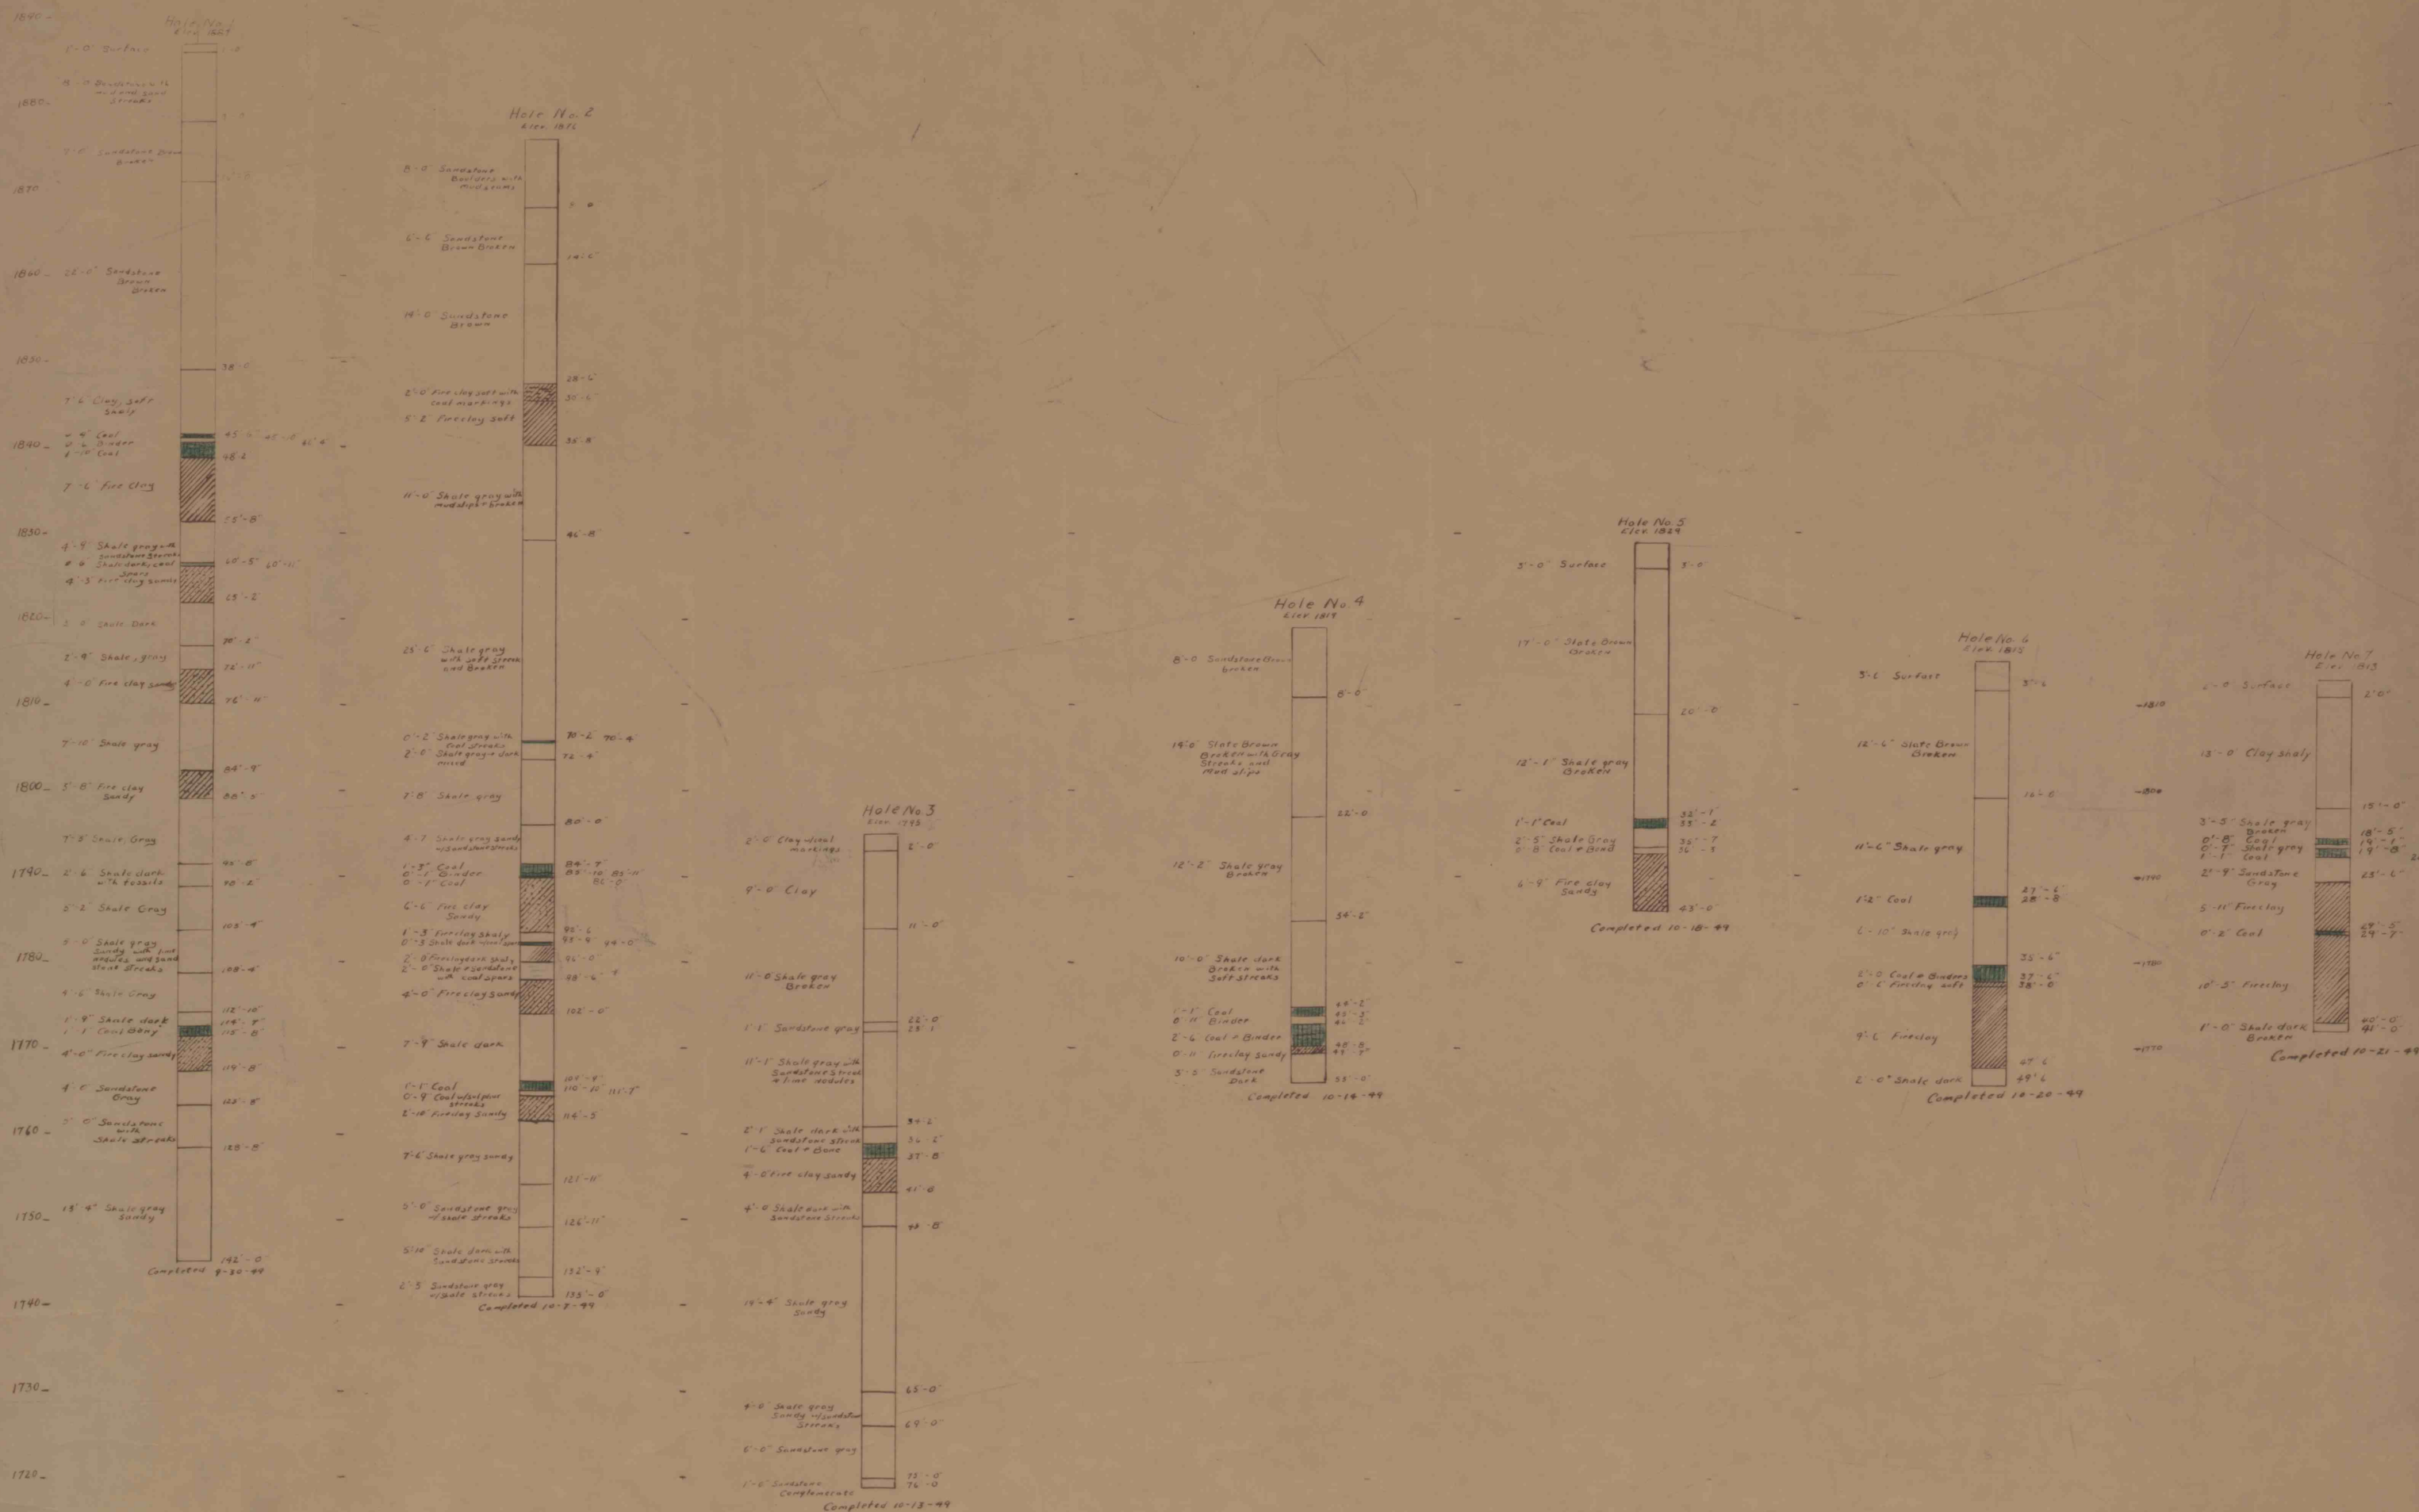

RECORD OF CORE DRILLING
 IN
 EXPLORATION FOR COAL
 VICINITY JOHNSBURG, PA.
 ARMSTRONG FOREST COMPANY
 Ventilation No. 10 January 10, 1950 C.H. Smalley
 Data from drill log 10-10-49
 of
 Kiffin & Sons, Pennsylvania, Pa.

