















MINE MAP
OF
PERRY HILLS COAL CO.

MINE NO. 3



PERRY TWP.

JEFF. CO., PA.

Scale 1 in. = 100 ft.

H. M. Kanarr, Eng'r.


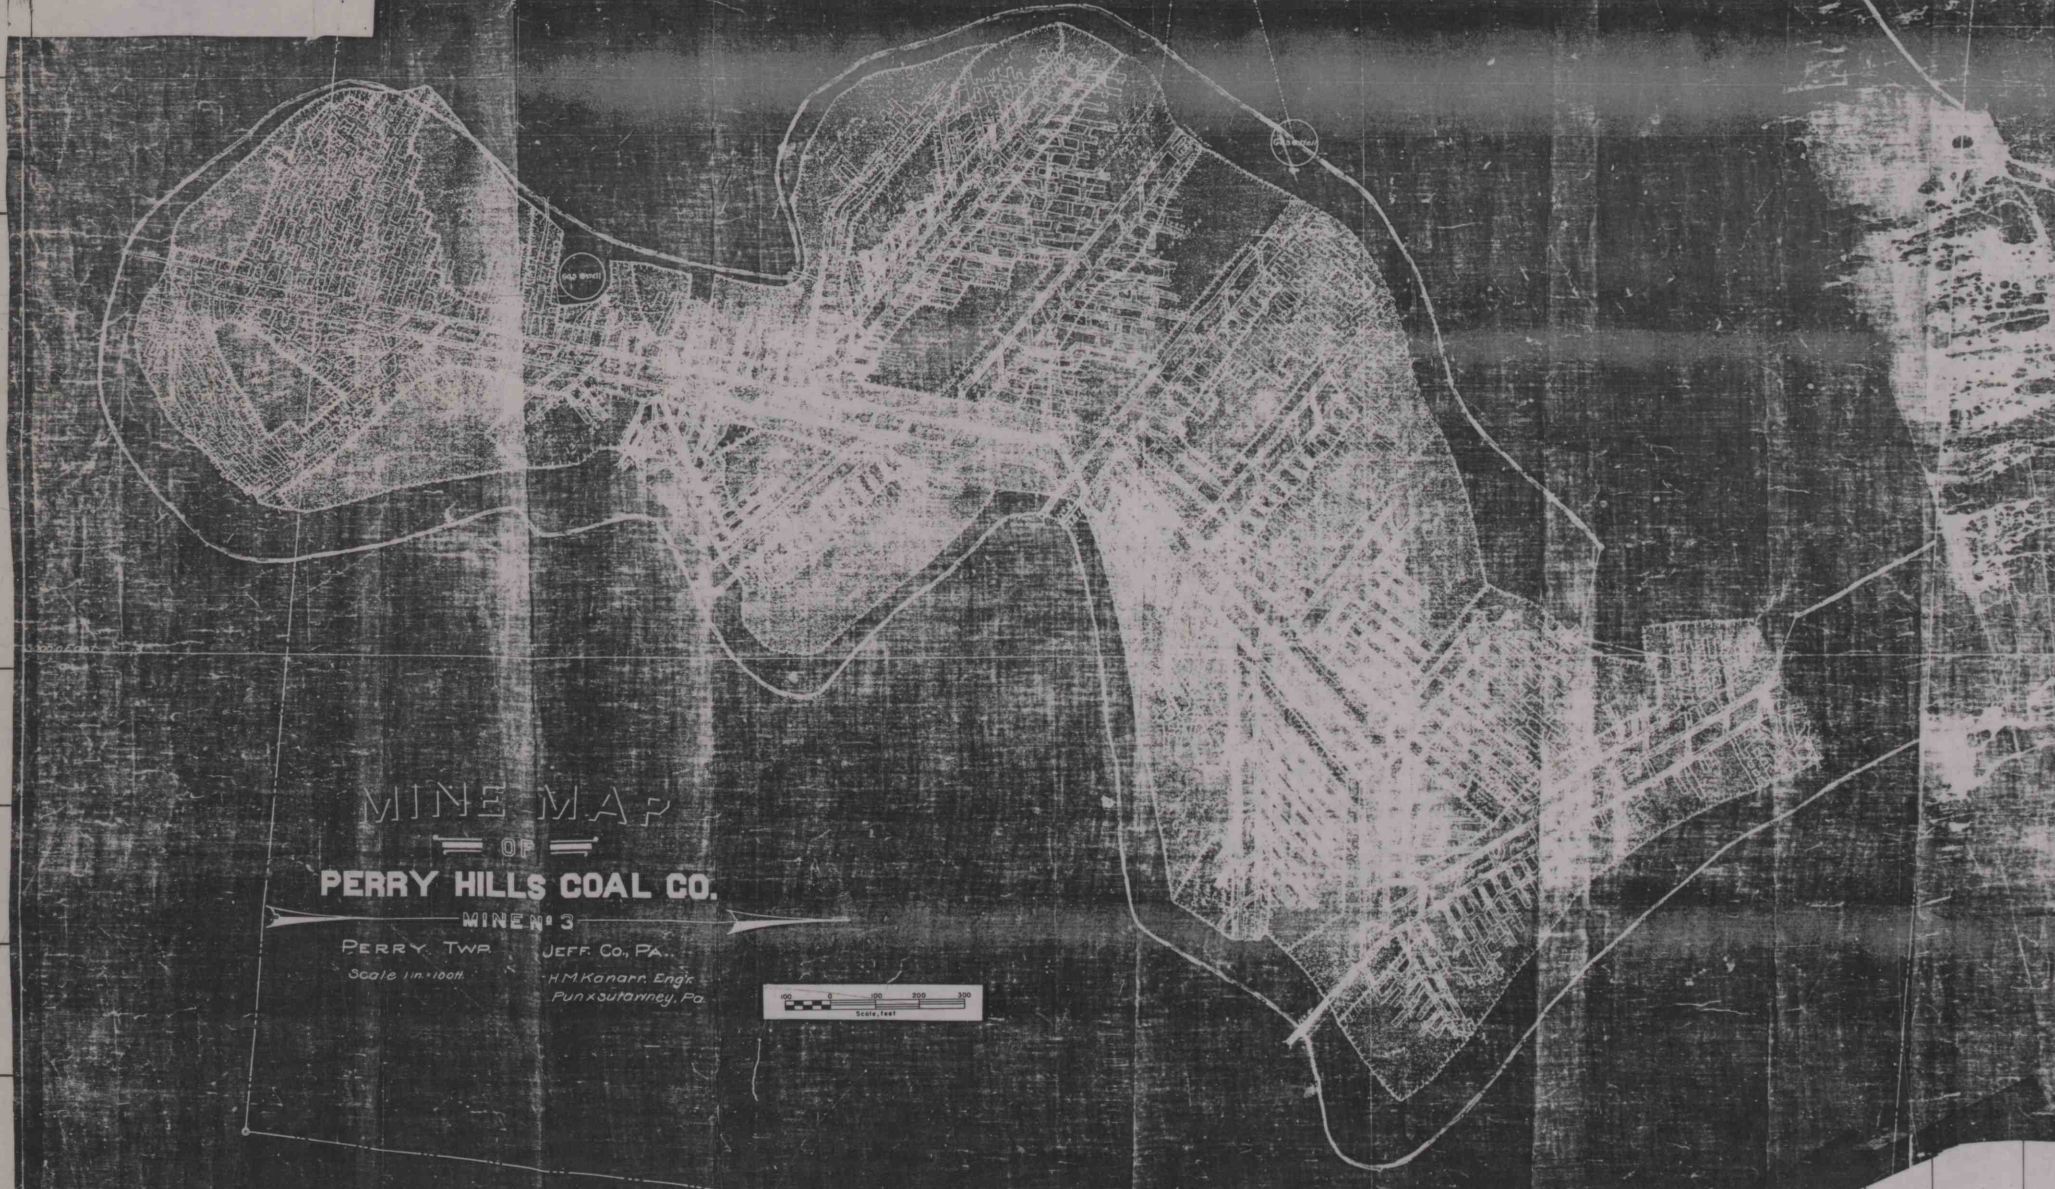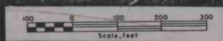

PDVMS

03040

87

35X

314562

34 32 30 28 26 24 22 20 18 16 14 12 10 8 6 4 2 0 2 4 6 8 10 12 14 16 18 20 22 24 26 28 30 32