


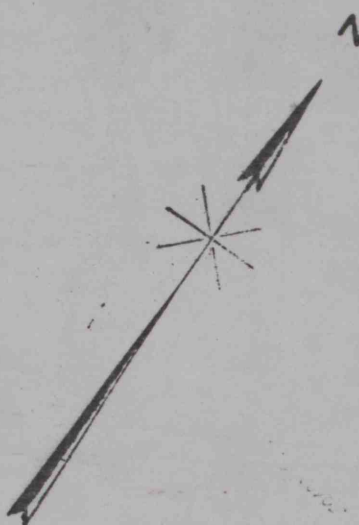

|         |                      |             |
|---------|----------------------|-------------|
| Correct | as of Dec. 31st 1929 | Map Revised |
| Correct | as of Dec. 31st 1928 | Map Revised |
| Correct | as of Dec. 31st 1927 | Map Revised |
| Correct | as of June 30th 1927 | Map Revised |
| Correct | as of June 30th 1926 | No Revision |
| Correct | as of June 30th 1925 | Map Revised |
| Correct | as of June 30th 1924 | No Revision |
| Correct | as of June 30th 1923 | Map Revised |
| Correct | as of June 30th 1922 | No Revision |
| Correct | as of June 30th 1921 | No Revision |
| Correct | as of June 30th 1920 | No Revision |
| Correct | as of June 30th 1919 | No Revision |

20

NOTE  
STATION 3009+60 ON THIS MAP EQUALS STATION 1736+90  
ON R. E. DEPT. LAND MAP NO. 176, Atlas 221.