


2

GLENWOOD COAL CO
 MAP OF #14 MINE
 SHOWING ENCROACHMENT ON PROPERTY OF
 THORNE COAL MINING CO
 SITUATED AT
 BURNSIDE CLEARFIELD, CO.
 Scale 1"=100' AB GICHTON Mining Engineer Johnstown Pa Feb 25 1920

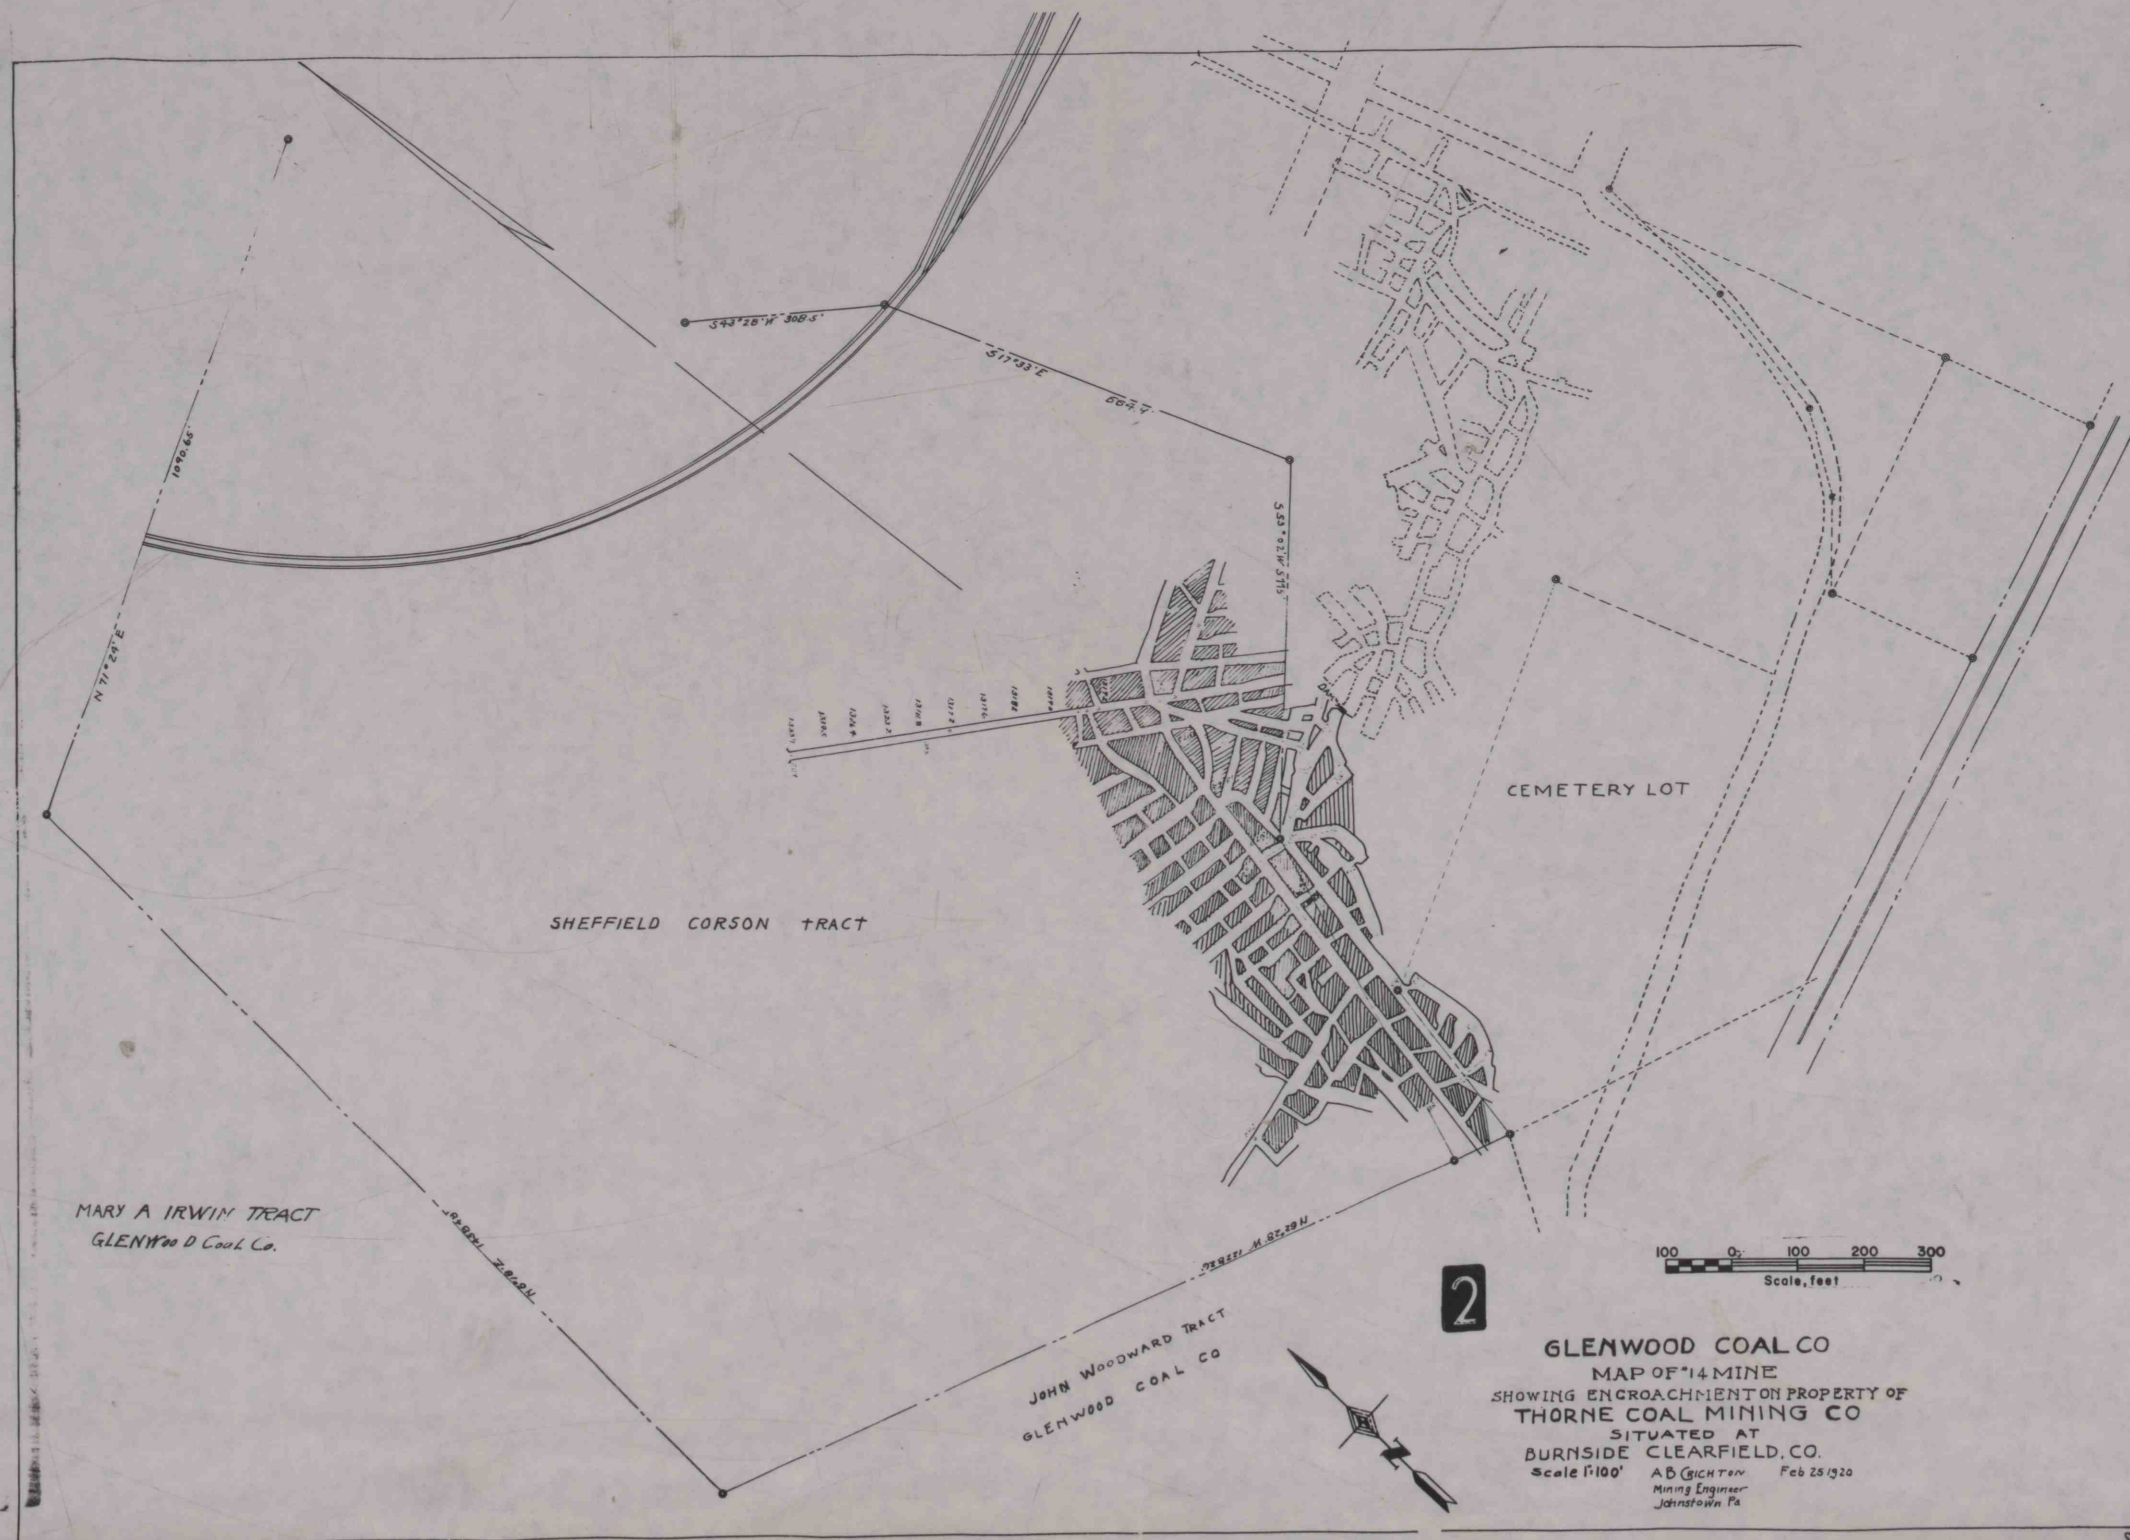