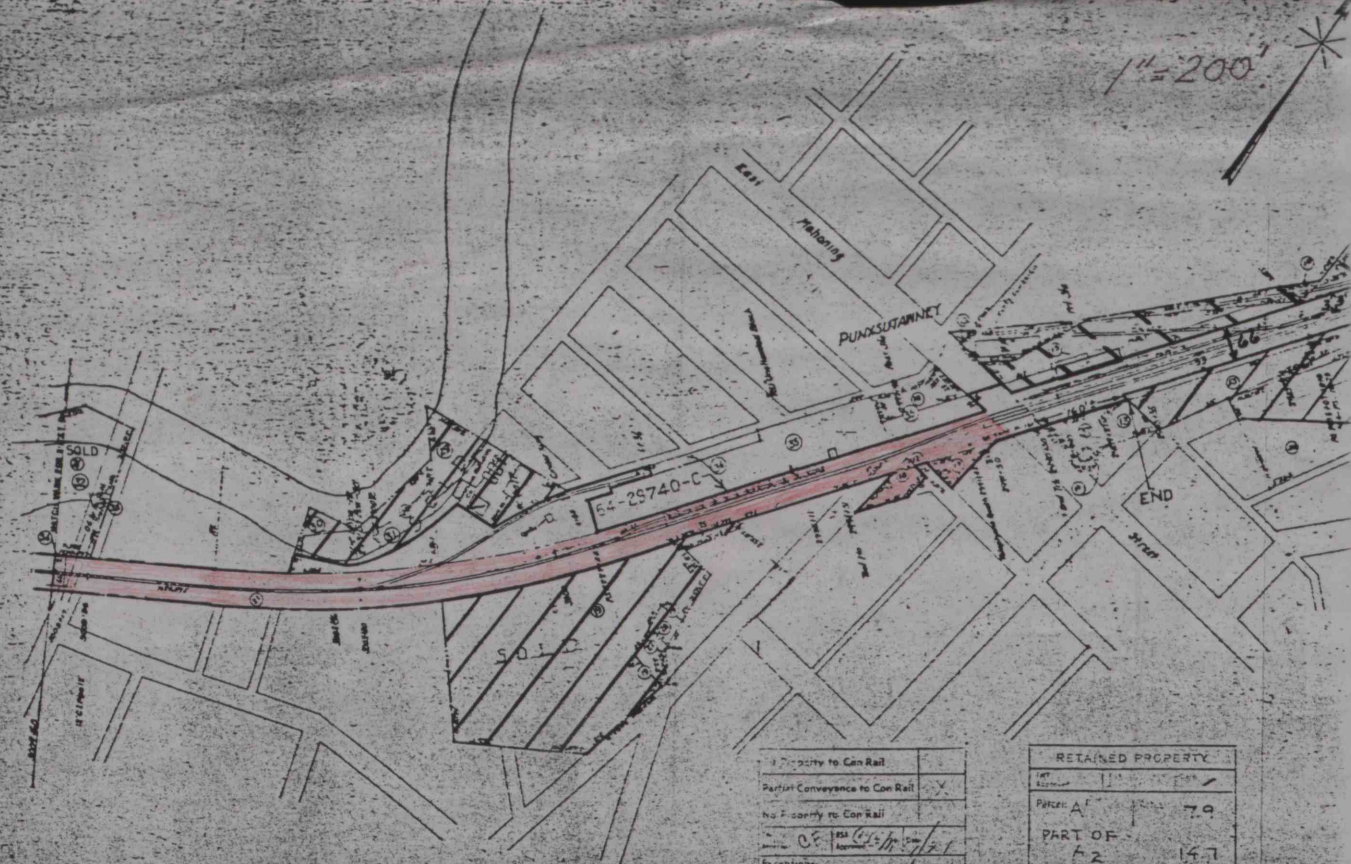


1"=200'

Property to Con Rail	
Partial Conveyance to Con Rail	X
No Property to Con Rail	
By Agreement	6/1/21

RETAINED PROPERTY	
Parcel A	7.9
