


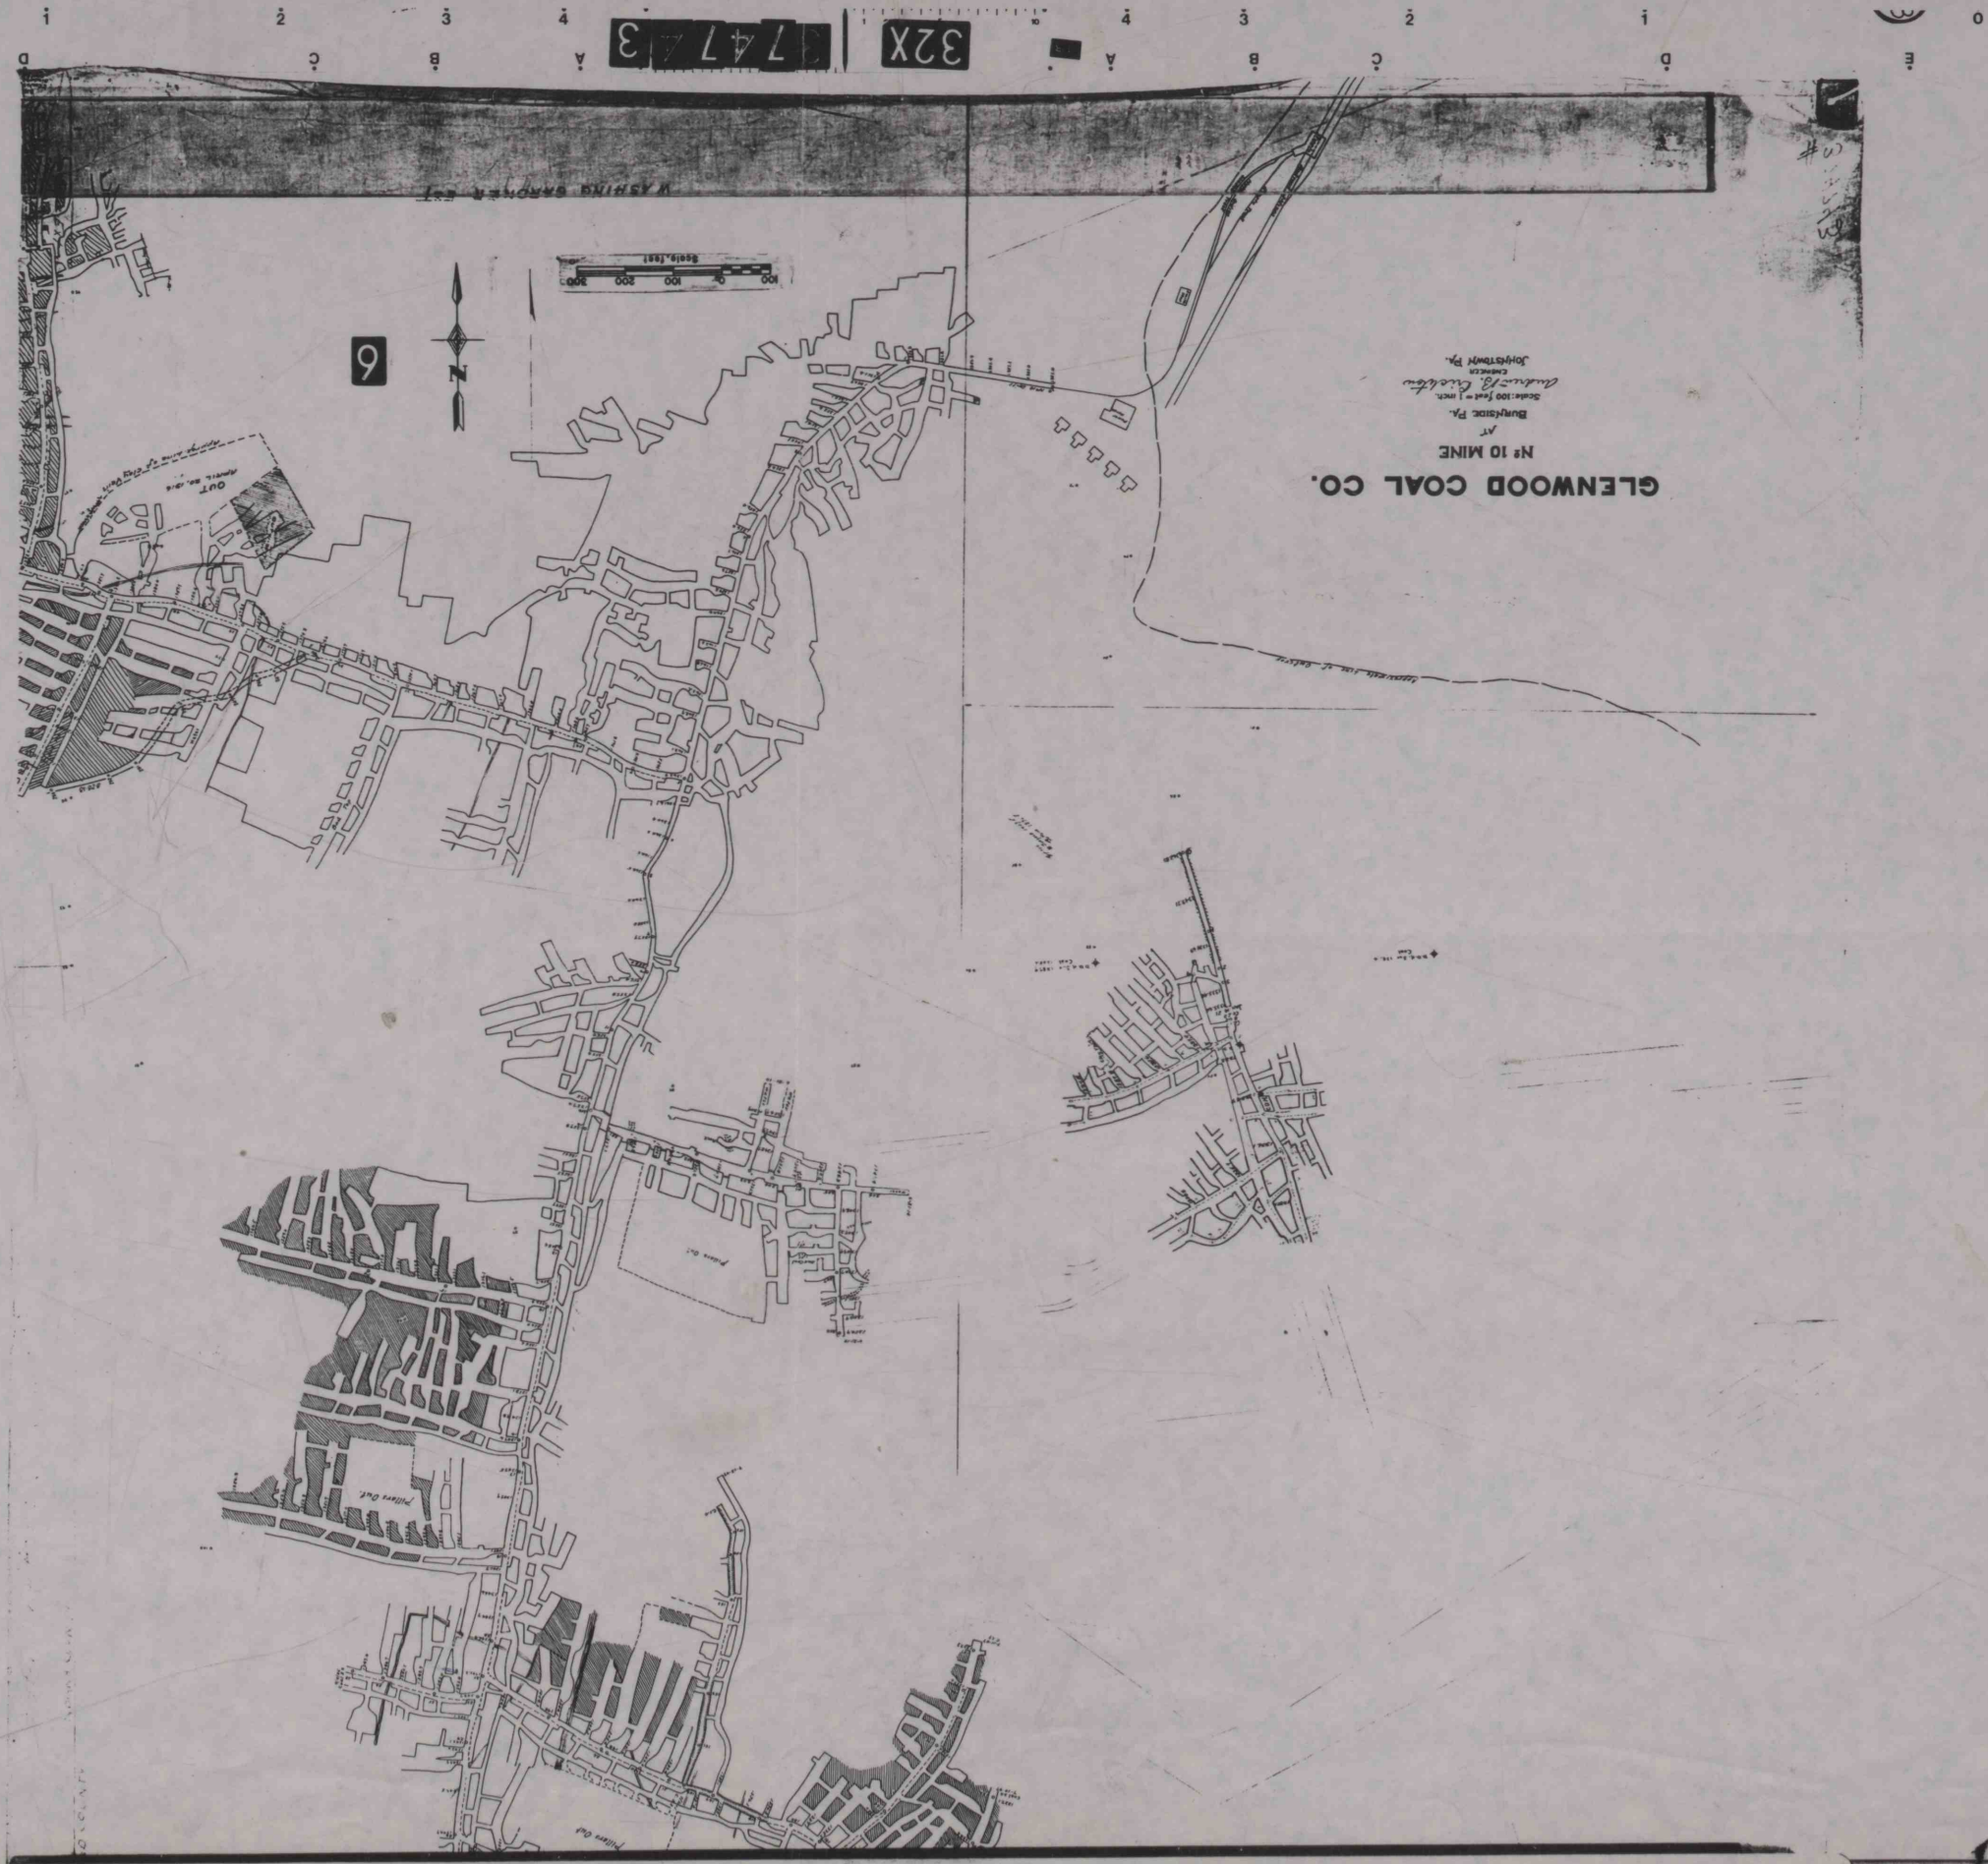

GLENWOOD COAL CO.
No 10 MINE

Scale: 100 feet = 1 inch.
Author: R. C. Cullen

32X 747 3

9