


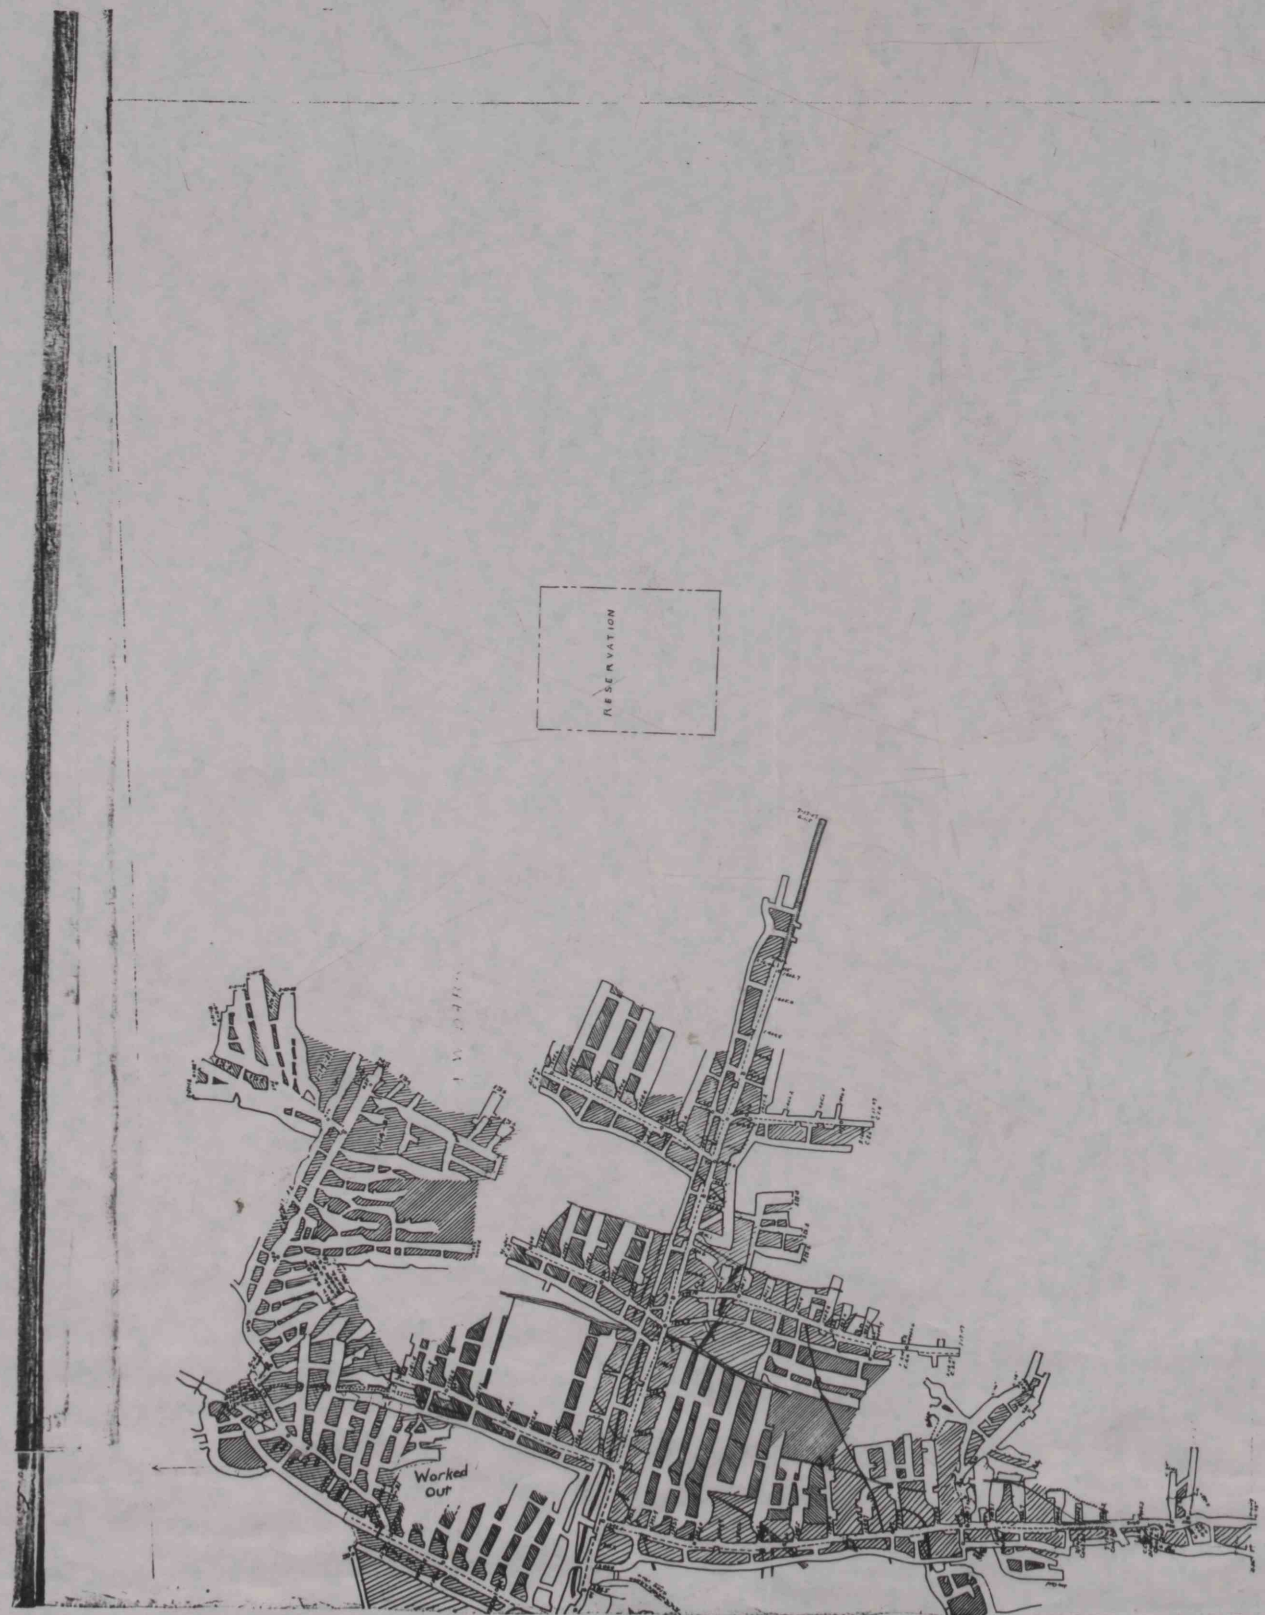

4

100 0 100 200 300
Scale, feet

E

D

C

B

A

29X

374743

A

B

C

D

E