

J-11-6

Sheet 2
Laurel Run Reclamation Company, Inc.
Laurel Ridge Mine
MSHA ID No. 36-08512
Brady, Union, Sandy Townships
Clearfield County

SCALE: 1"=100'
7/25/96
HESS & FISHER ENGINEERS, INC.
CONSULTING ENGINEERS & GEOLOGISTS
36 NORTH SECOND STREET
CLEARFIELD, PA 16830 814-765-7541

C:\ACAD12\LAUREL\LRVENT.DWG

APPROVED: _____ ENGINEER
REG. NO. _____ DATE: _____

SEAL


MINE WORKS TO DATE, 1/29/97, K.W.B.

LEGEND

- EXTENT OF PERMIT
- ||| LOWER KITTANNING HIGHWALL
- G GAS TRANSMISSION LINE
- INTAKE AIR CURRENT
- RETURN AIR CURRENT
- REDUCED FLOW INTAKE AIR CURRENT
- == PERMANENT STOPPINGS
- ~ CHECK CURTAIN
- == BELTS
- ⌒ DOORS
- LINE BRATTICE
- R REGULATOR
- △ ESCAPEWAY
- ▽ ALTERNATE ESCAPEWAY
- DEVELOPMENT PLANS
- WATER LINE

MATCH TO SHEET 1

CHAGRIN LAND, LTD. - PARCEL 4
SURFACE
PATRICK H. MOWERY &
KIM MOWERY HOBBA, TRUSTEES
MINERALS

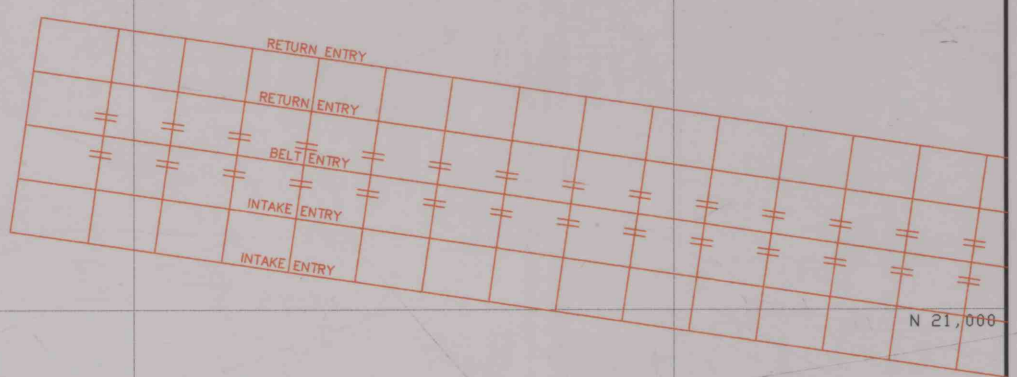

N 21,000

NOTE: MINING IS ON THE LOWER KITTANNING COAL

MATCH TO SHEET 1