


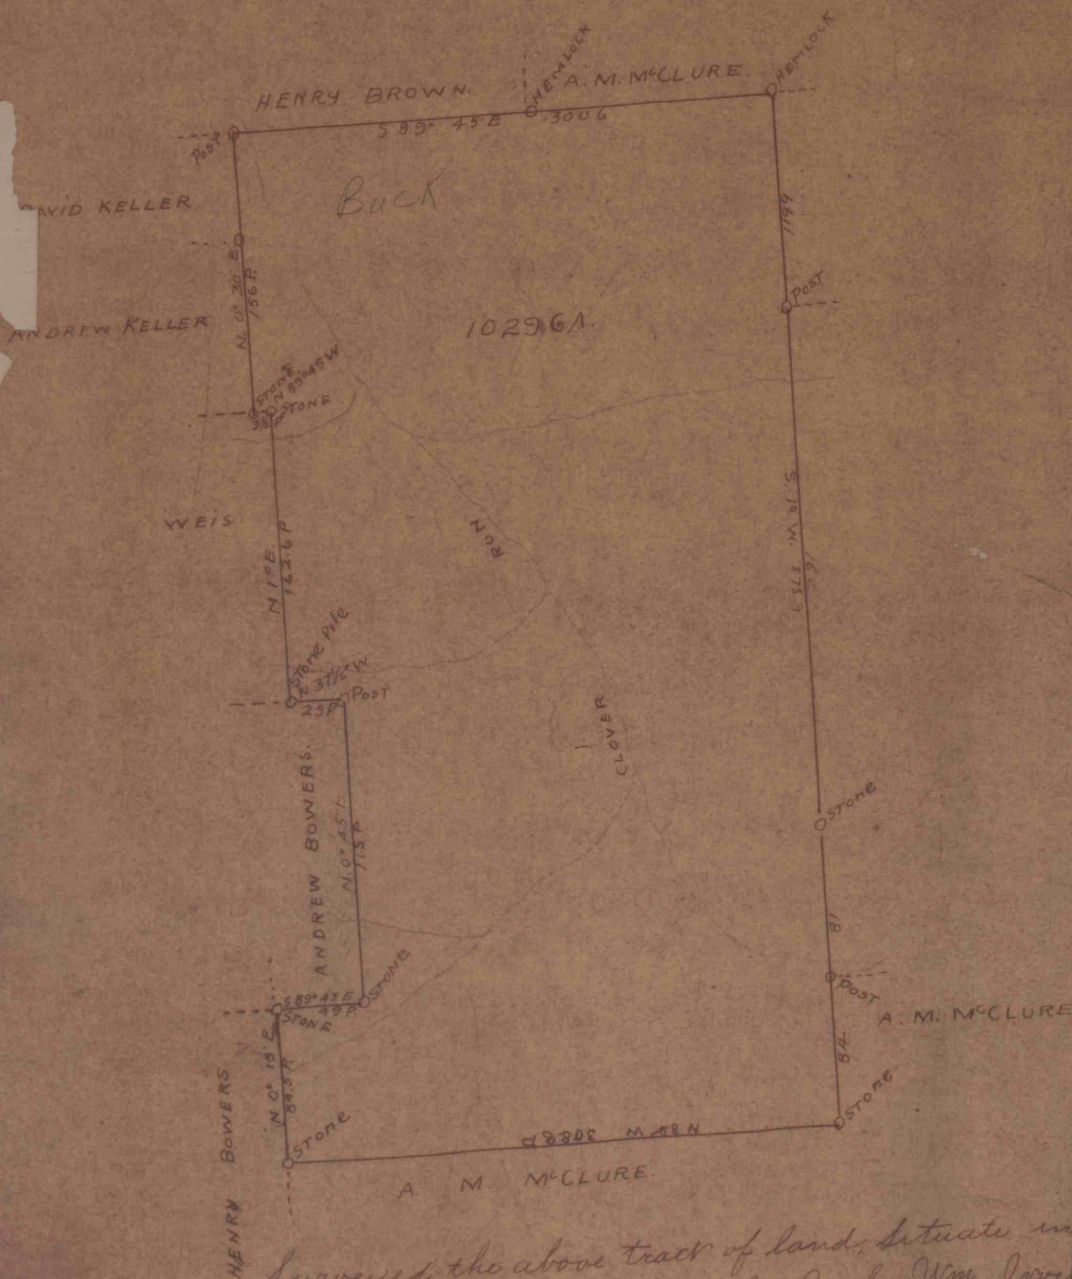

Surveyed the above tract of land, situate in
 Oakhill Twp Jefferson Co, Pa, for Wm Irvine
 Augt. 1892
 Scale - 60 P. = 1'

Buck I HAD THIS PROPERTY SEARCH IT NOW
 BELONGS TO PA GAME COMMISSION AND WE CAN DO
 NOTHING WITH IT

Fred