


H-19-1

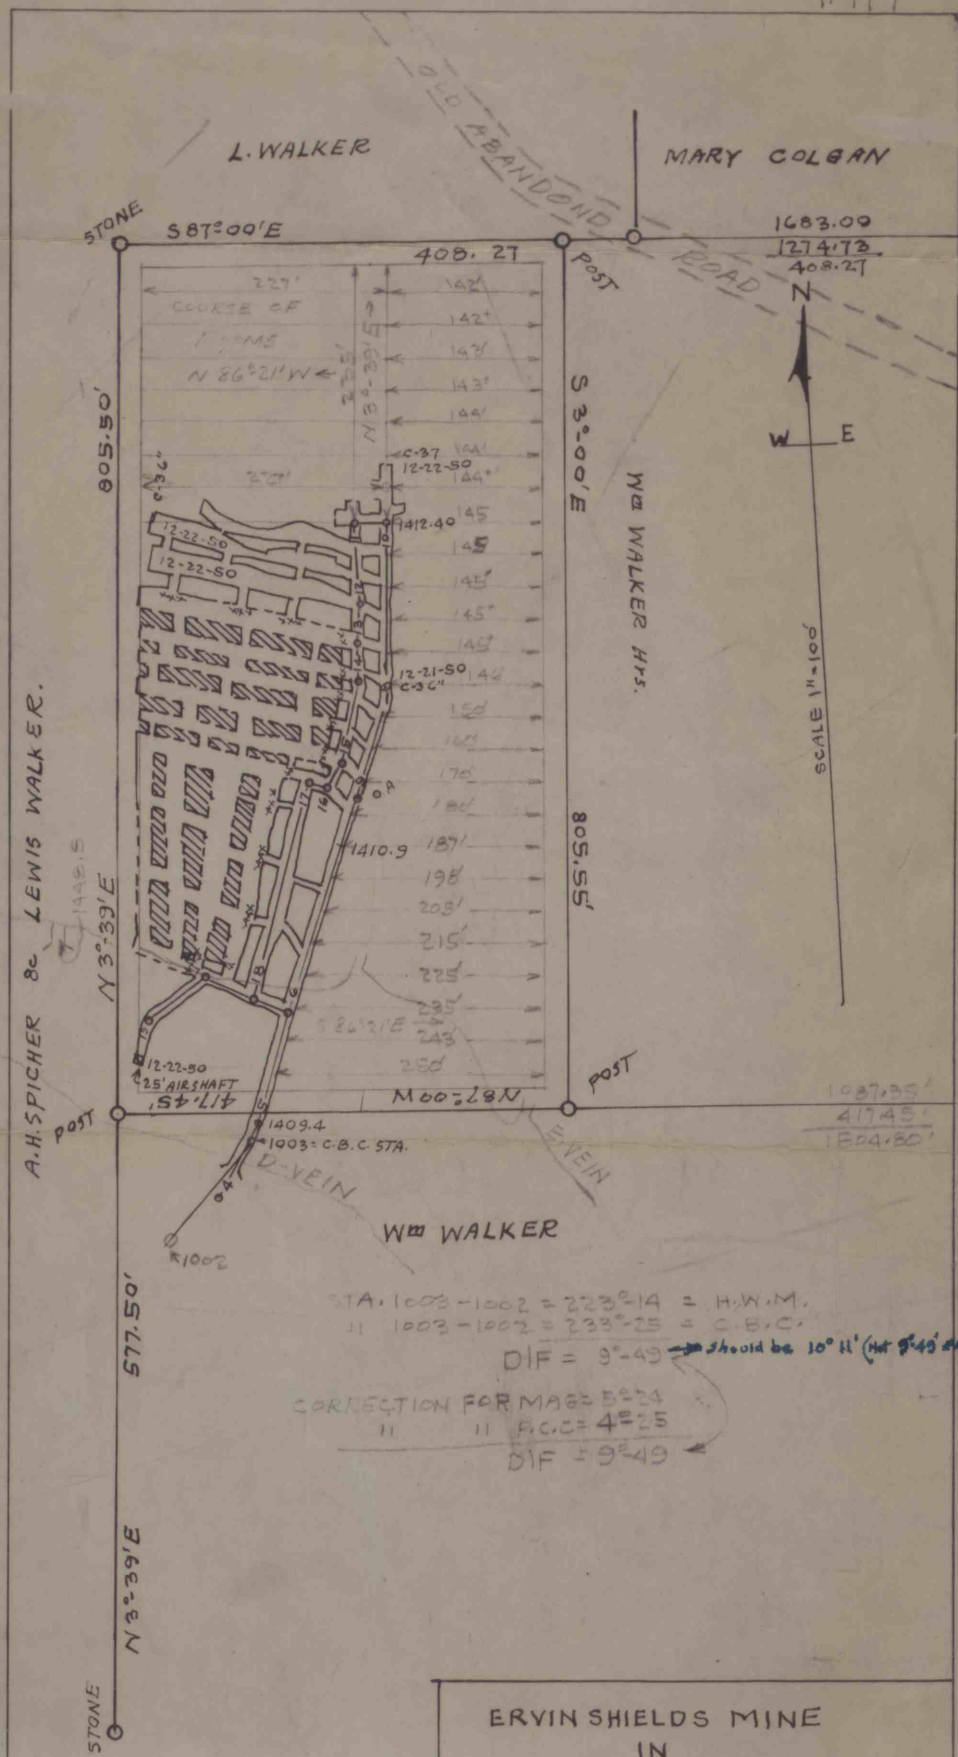

$STA. 1003 - 1002 = 223^{\circ} 14' = H.W.M.$
 $II \quad 1003 - 1002 = 233^{\circ} 25' = C.B.C.$
 $DIF = 9^{\circ} 49'$ *Should be 10° N' (not 9° 49' error)*
 $CORRECTION FOR MAG = 5^{\circ} 24'$
 $II \quad II \quad P.C.C. = 4^{\circ} 25'$
 $DIF = 9^{\circ} 49'$

ERVIN SHIELDS MINE
 IN
 MONTGOMERY TWP.
 INDIANA CO. PA.
 10-A RES. DEED N: 8119
 SUR-10-22-50 BY —
 H.W. MIKESELL-R.P.E.