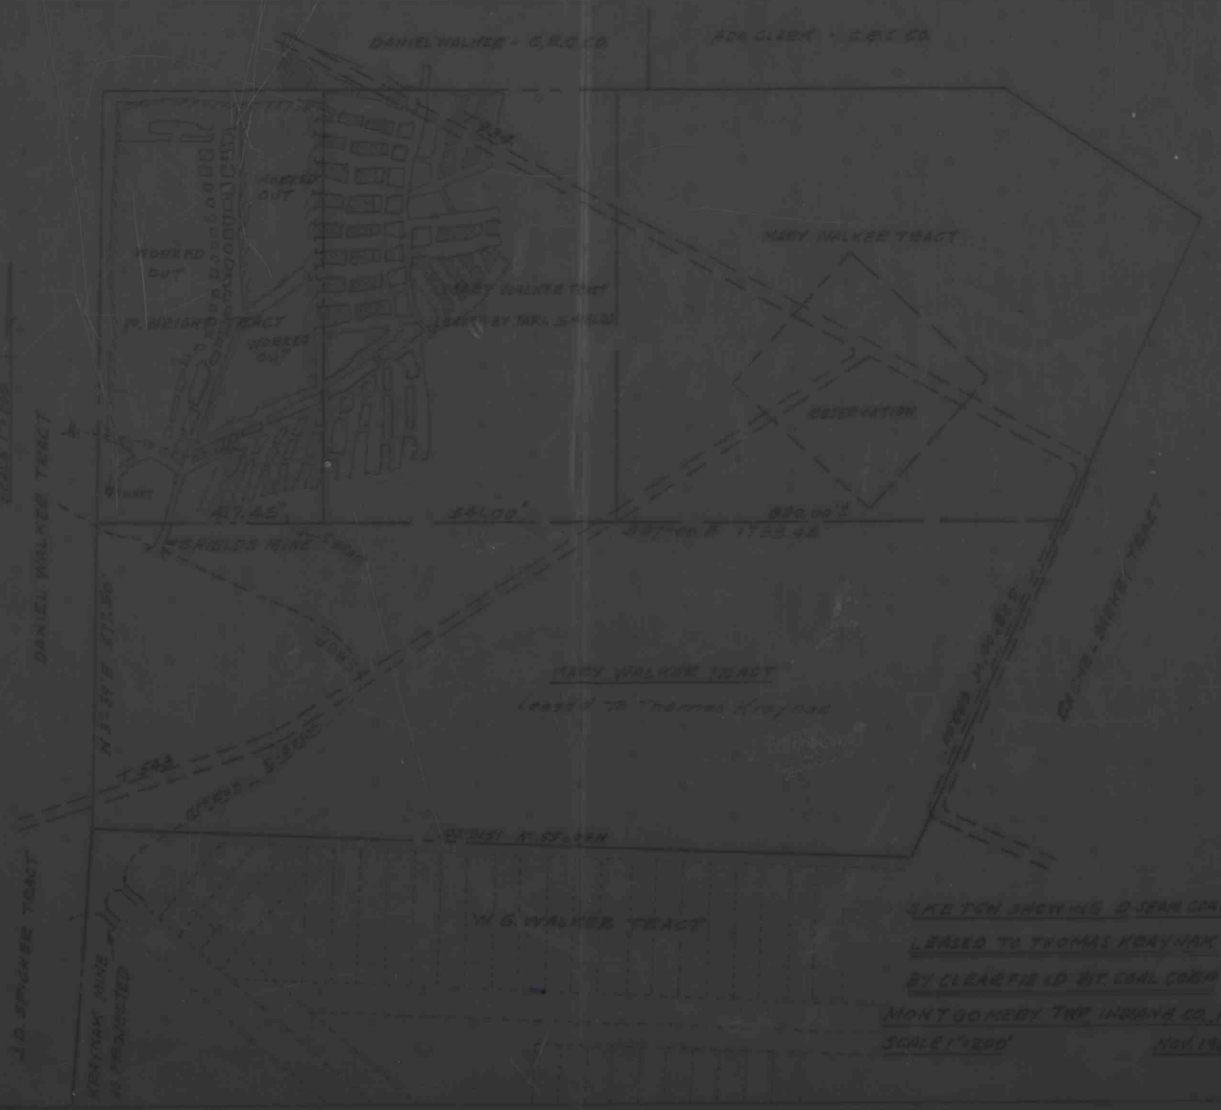



SKETCH SHOWING B-SEAM COAL
LEASED TO THOMAS KOMYNAK
BY CLEARFIELD BIT. COAL CORP
MONTGOMERY TWP. INDIANA CO. PA
SCALE 1"=200' NOV. 1953

(6)