H-19-5

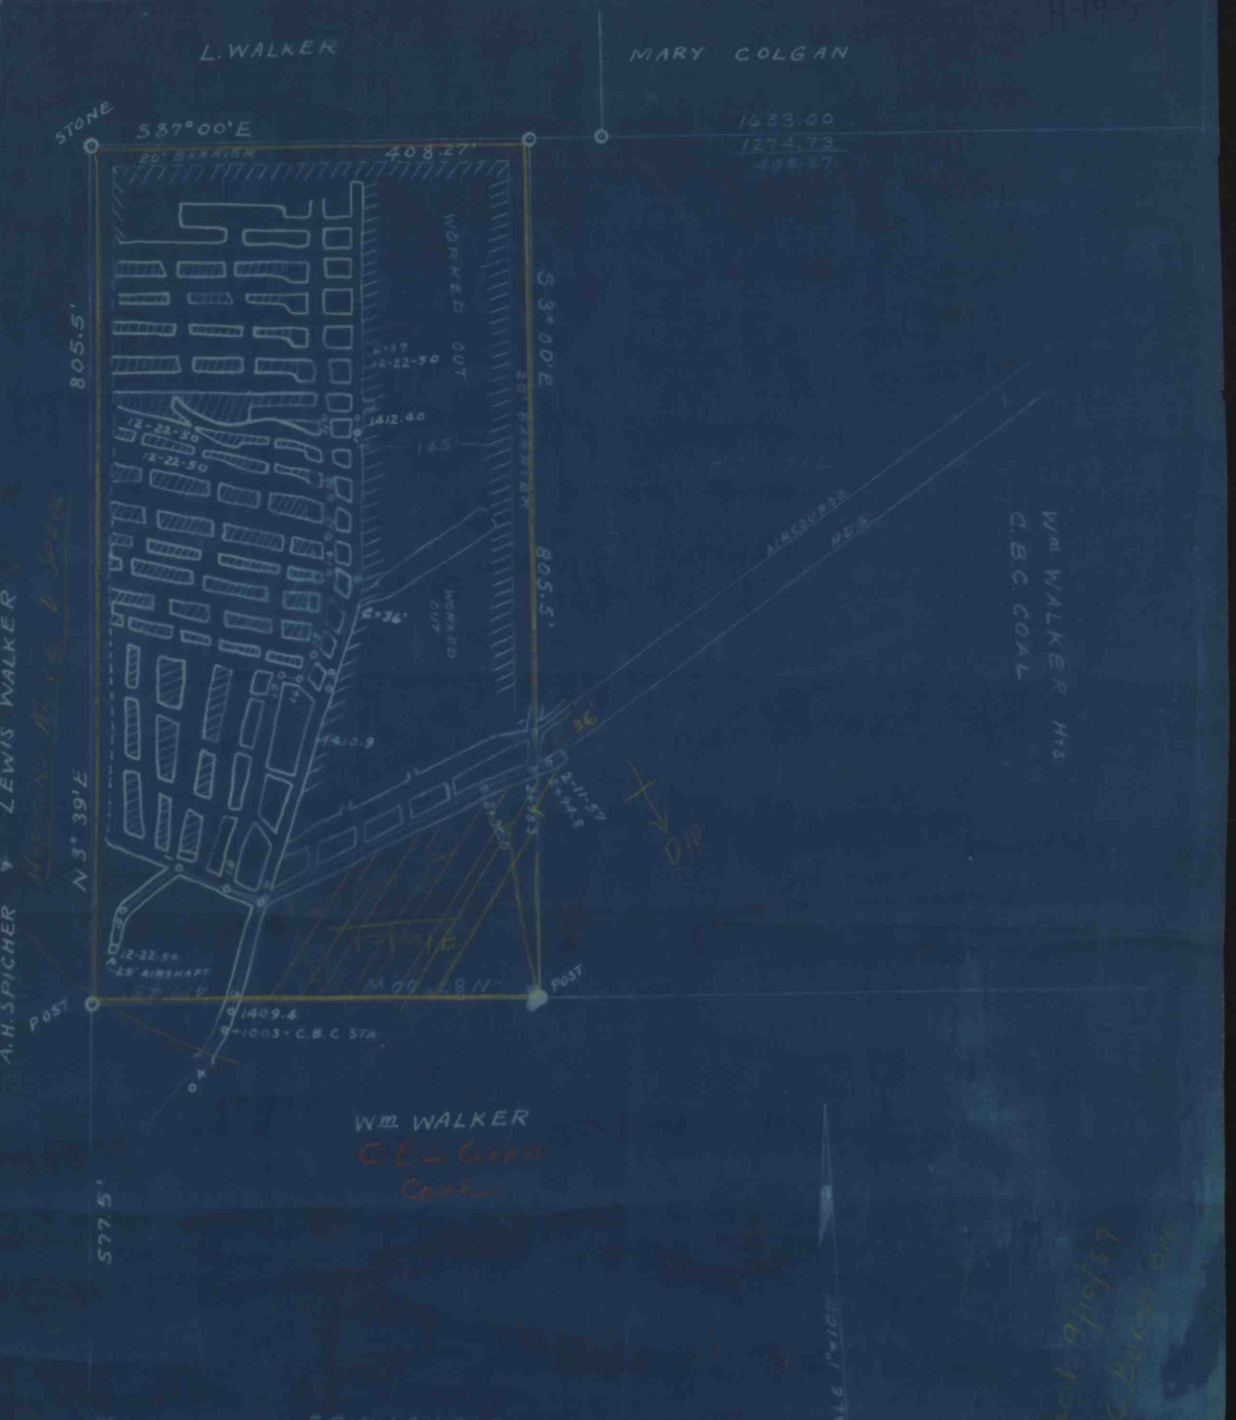

ERVIN SHIELDS MINE D-SEAM
OPERATED BY F.C. BURNS
MONTGOMERY TWP
INDIANA CO. PA.
10-A RES. DEED No 8119
SUR. 10-22-50 BY H.W. MIKESELL
SUR. 2-11-57 BY THOMAS HOWORTH

N 3° 39' E
STONE