





N-4500
E-4000

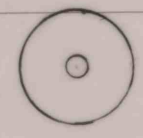

N-4400
E-4000

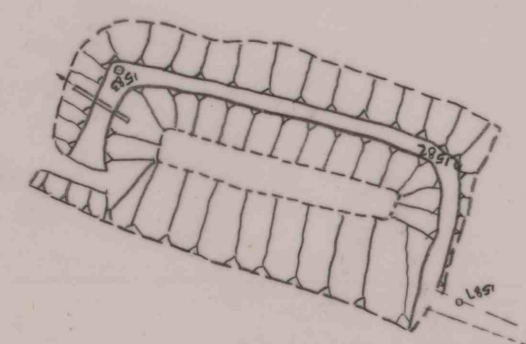

1591

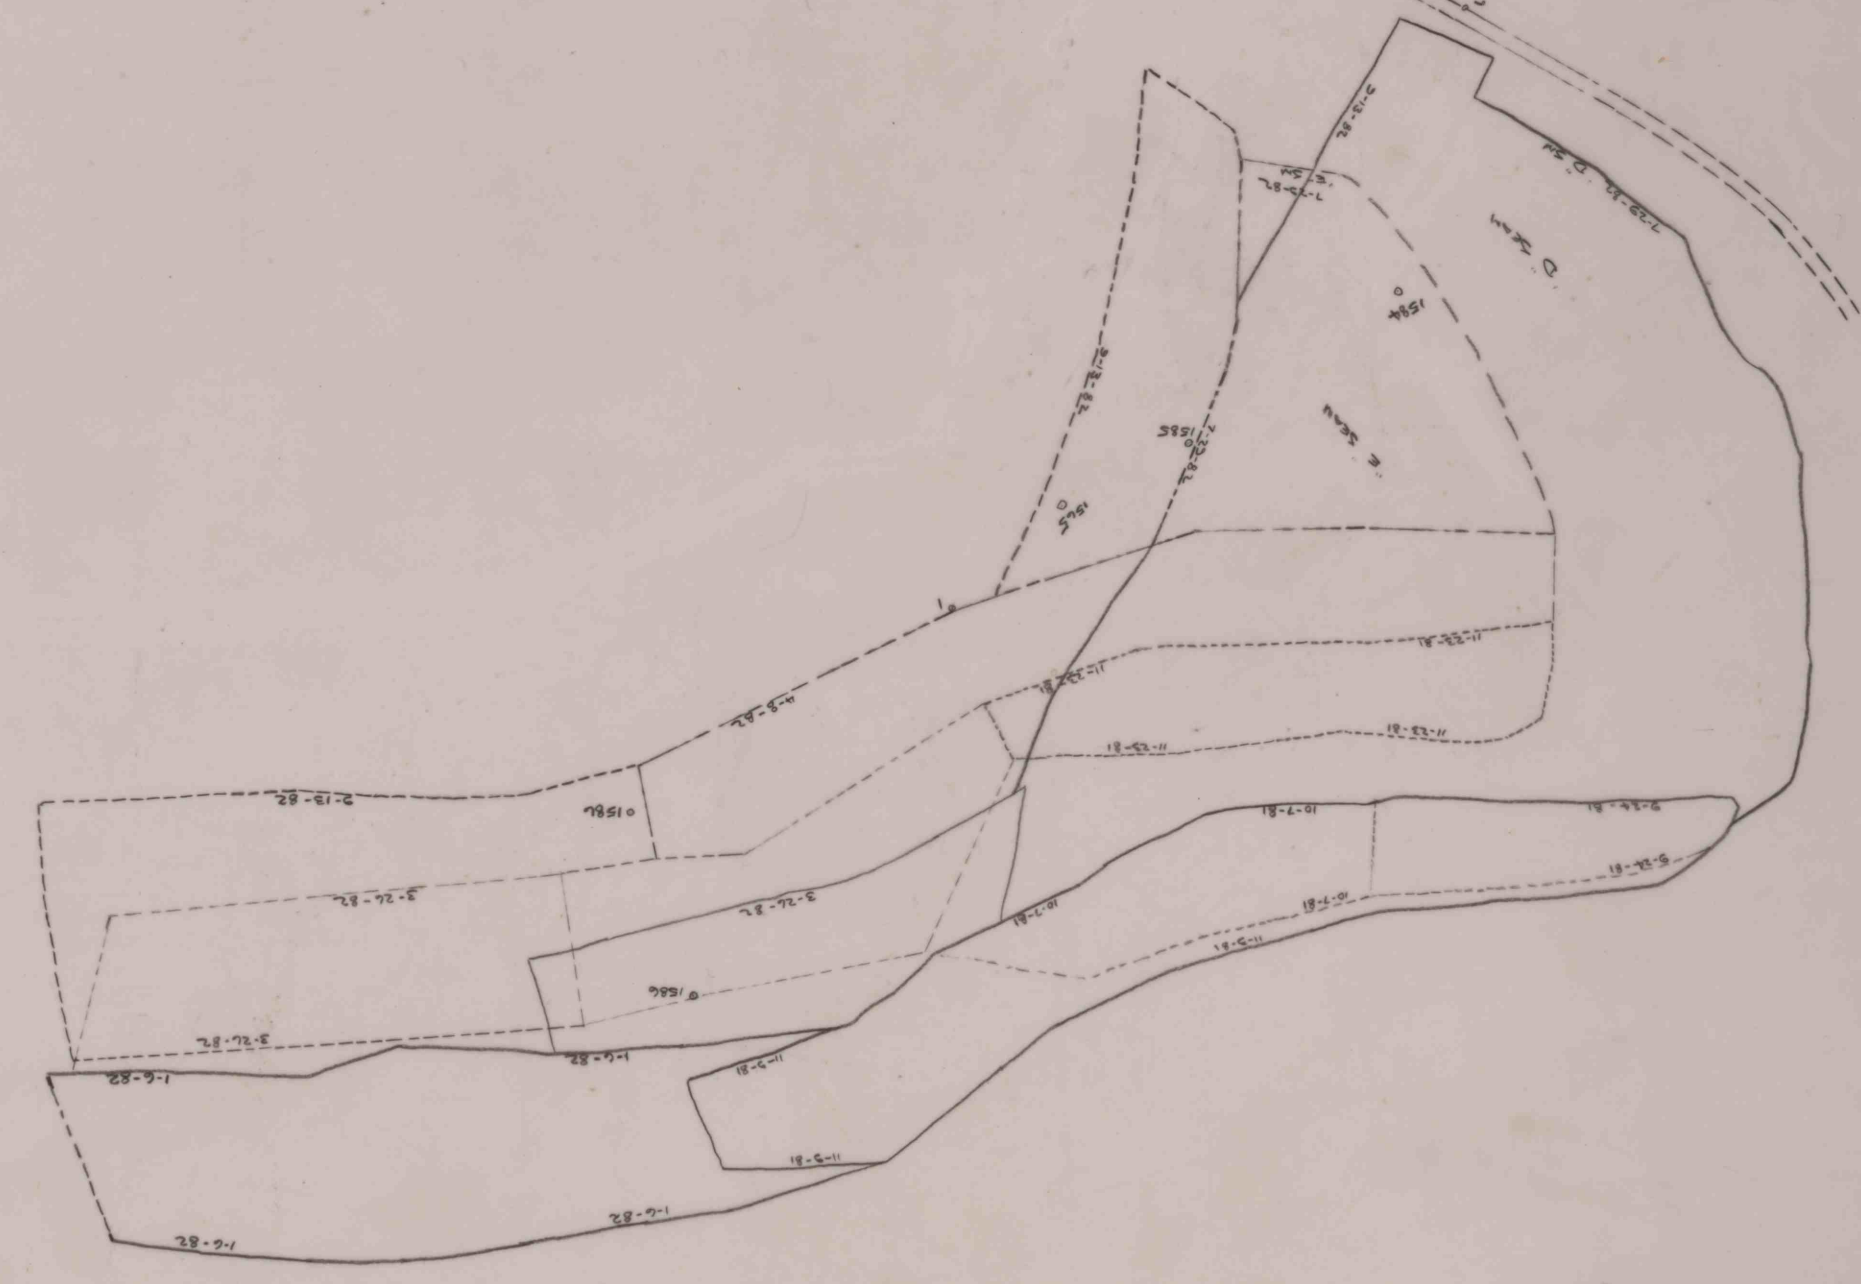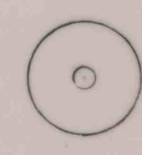

N-4500
E-4000

N-4600
E-4000