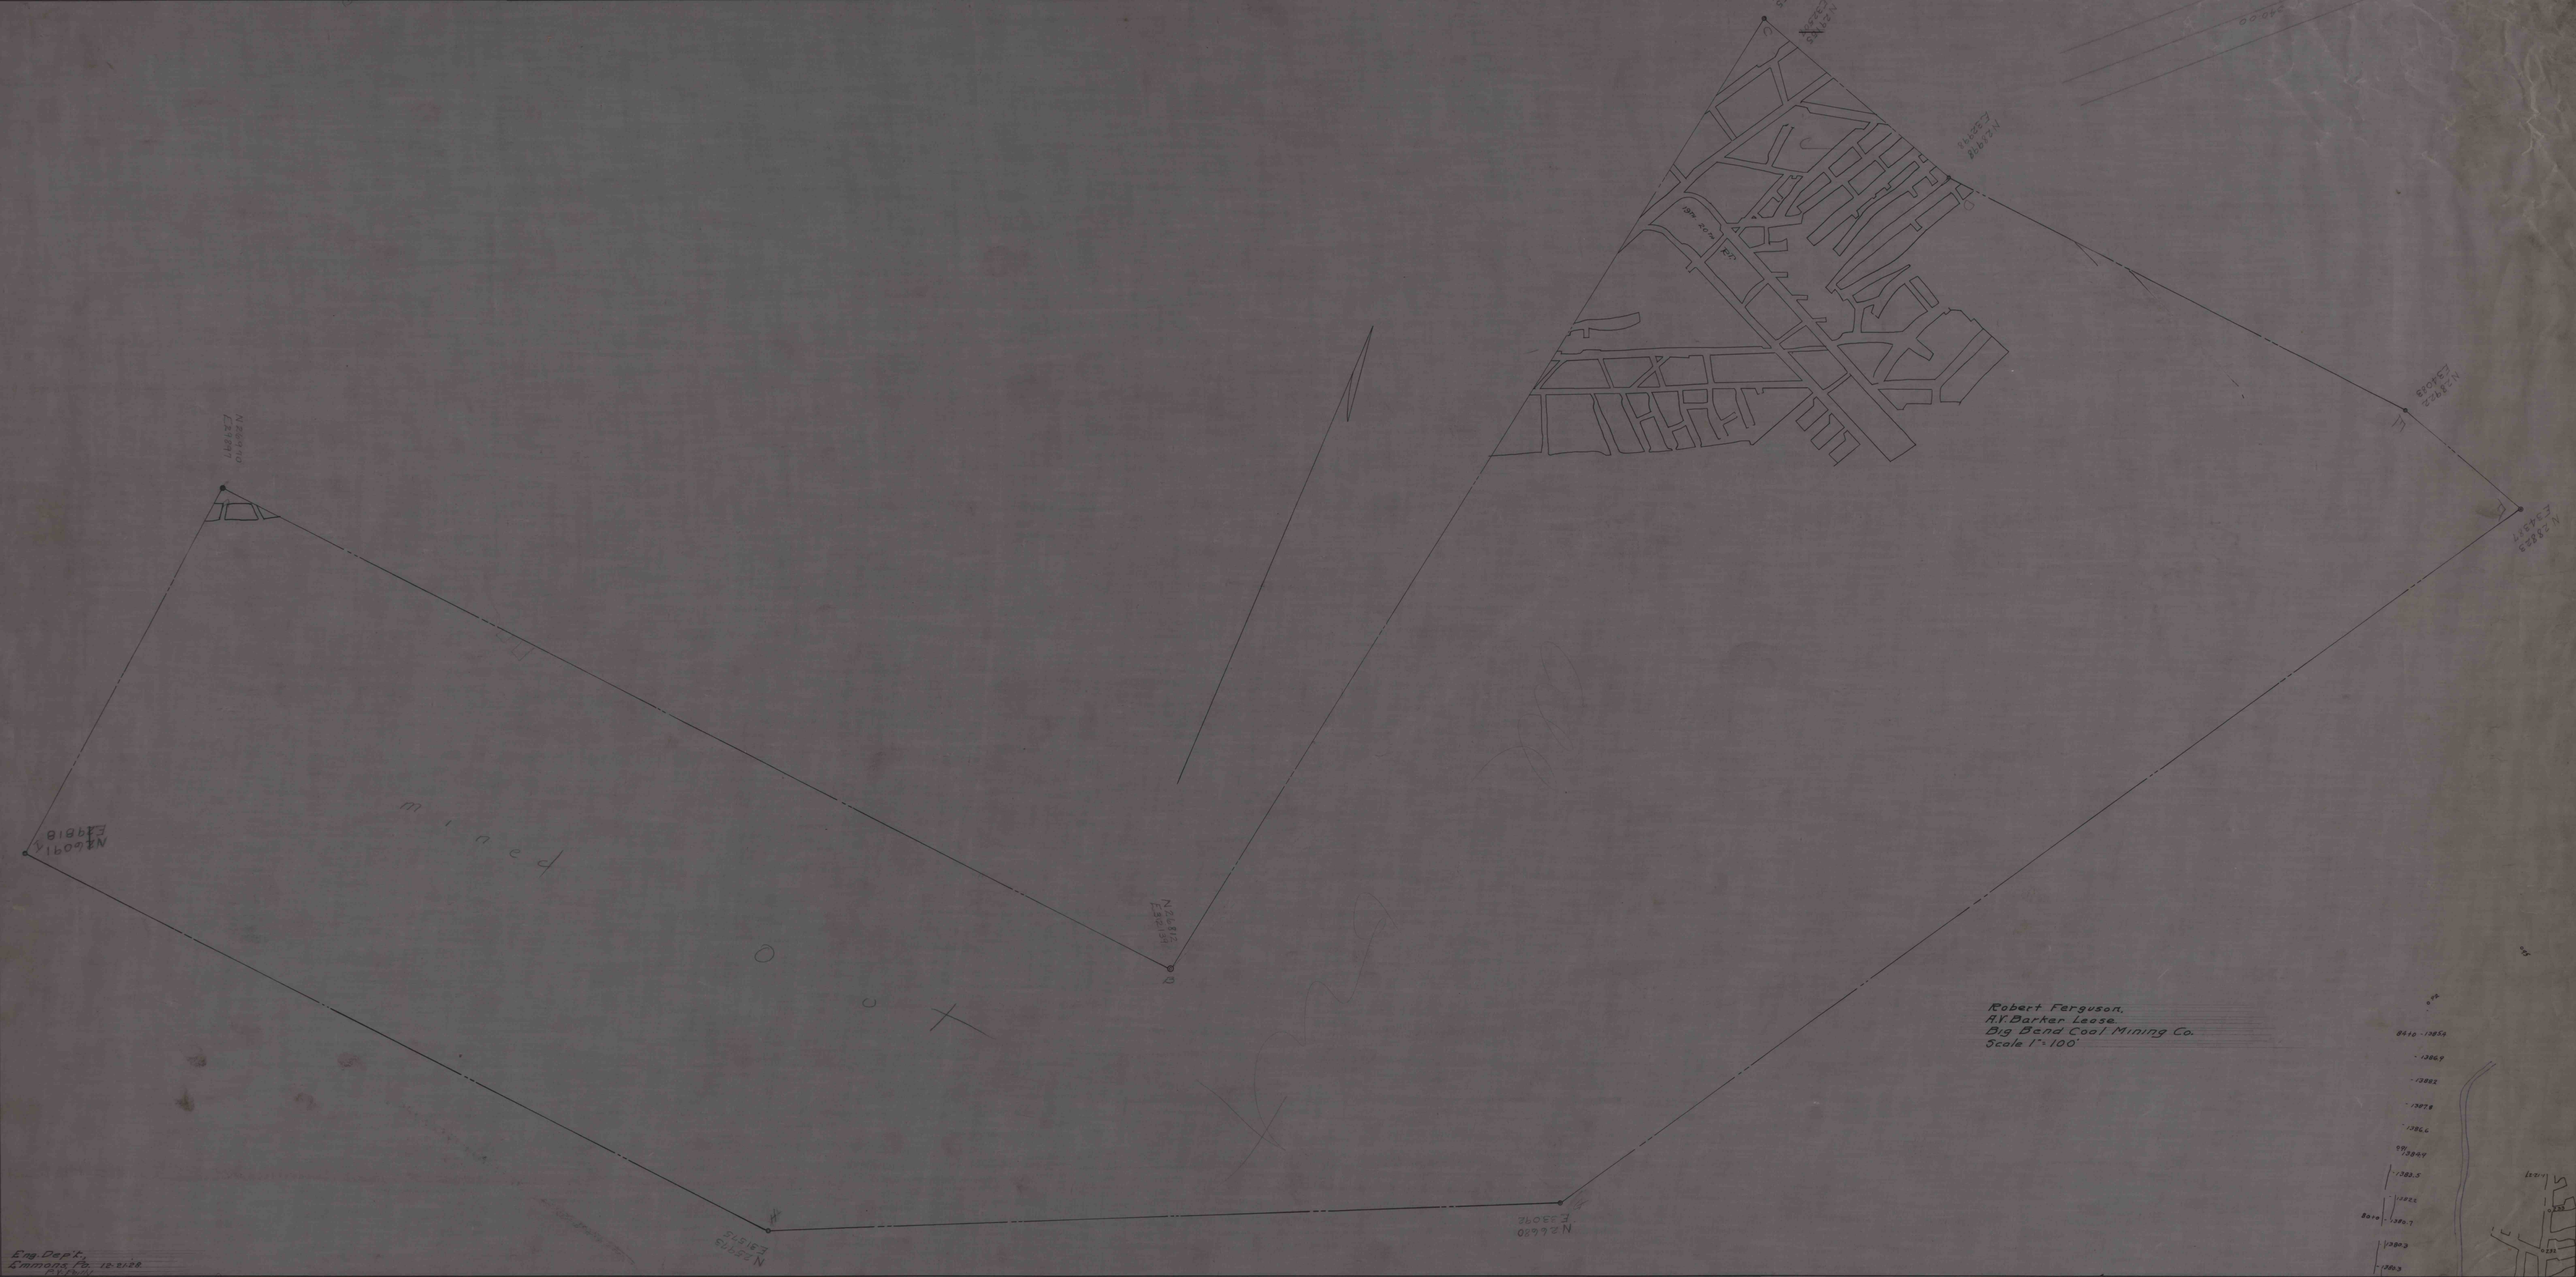
mined out
Robert Ferguson,
A.V. Barker Lease,
Big Band Coal Mining Co.
Scale 1"=100'
Eng. Dept.
Emmons Pa. 12-2128