


585.50'E - 483.6'

603.11'

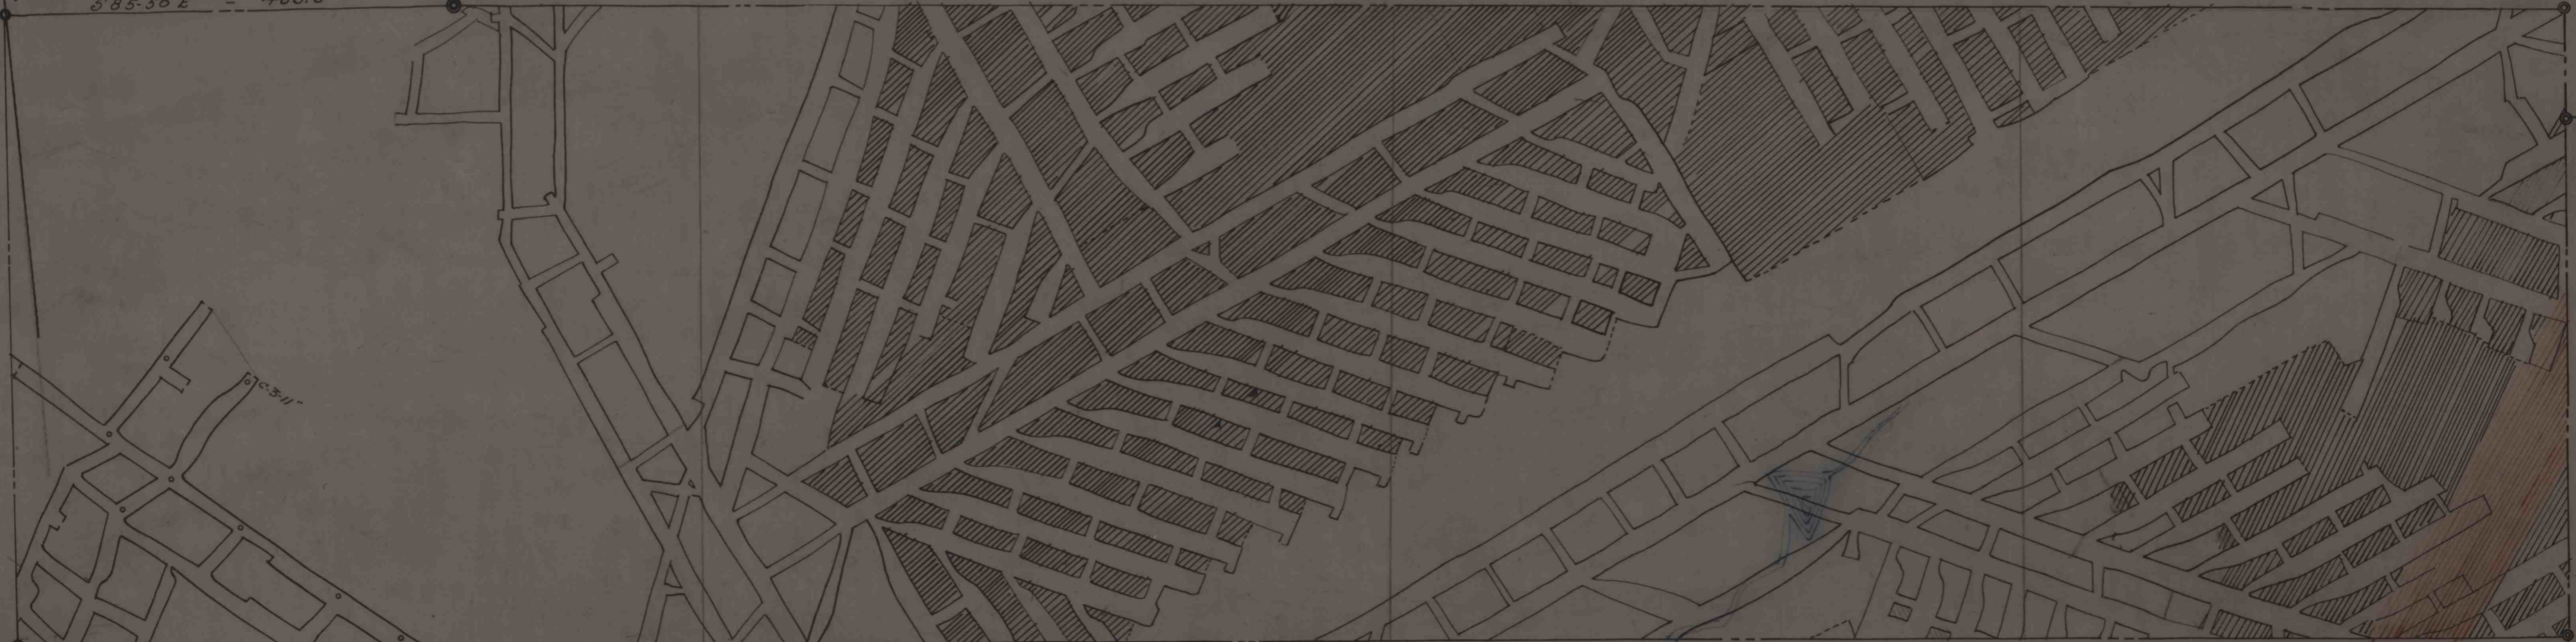

Eng. Dept.,
Emmons, Pa. 12-20-28.

Henry Campbell - 1
A.V. Barker Lease.
Big Bend Coal Mining Co.
Scale 1"=100'

P.V. 12.11.11