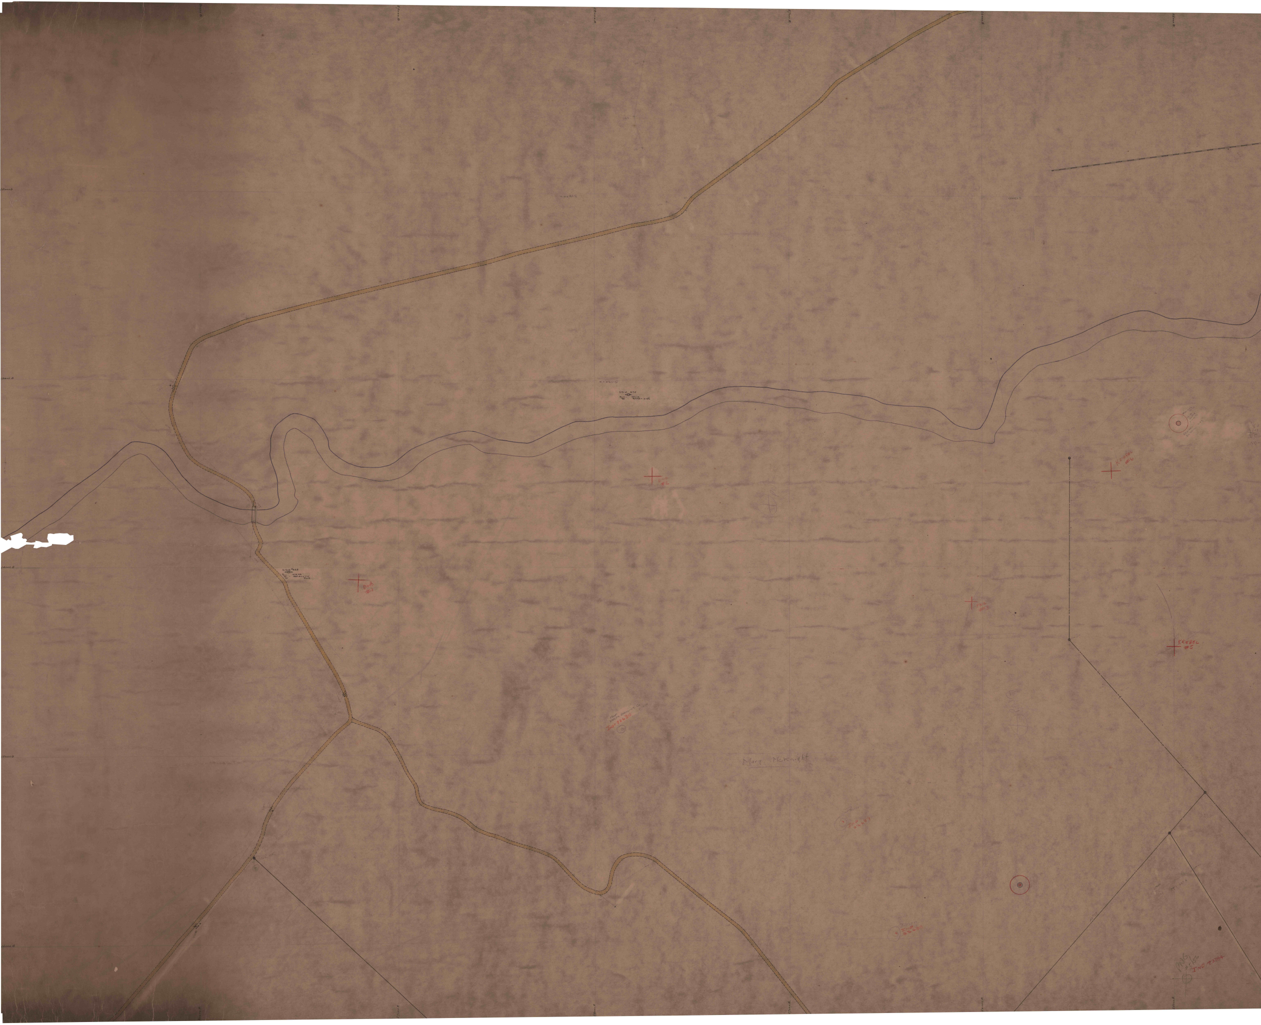
Mary McKnight
D+A #1
D+A #2
PNG #3
KRIEBEL #6
KRIEBEL #5
Delta Drilling Co
IND 22630
IND 22637
IND 22628
PNG #5156
IND 23784

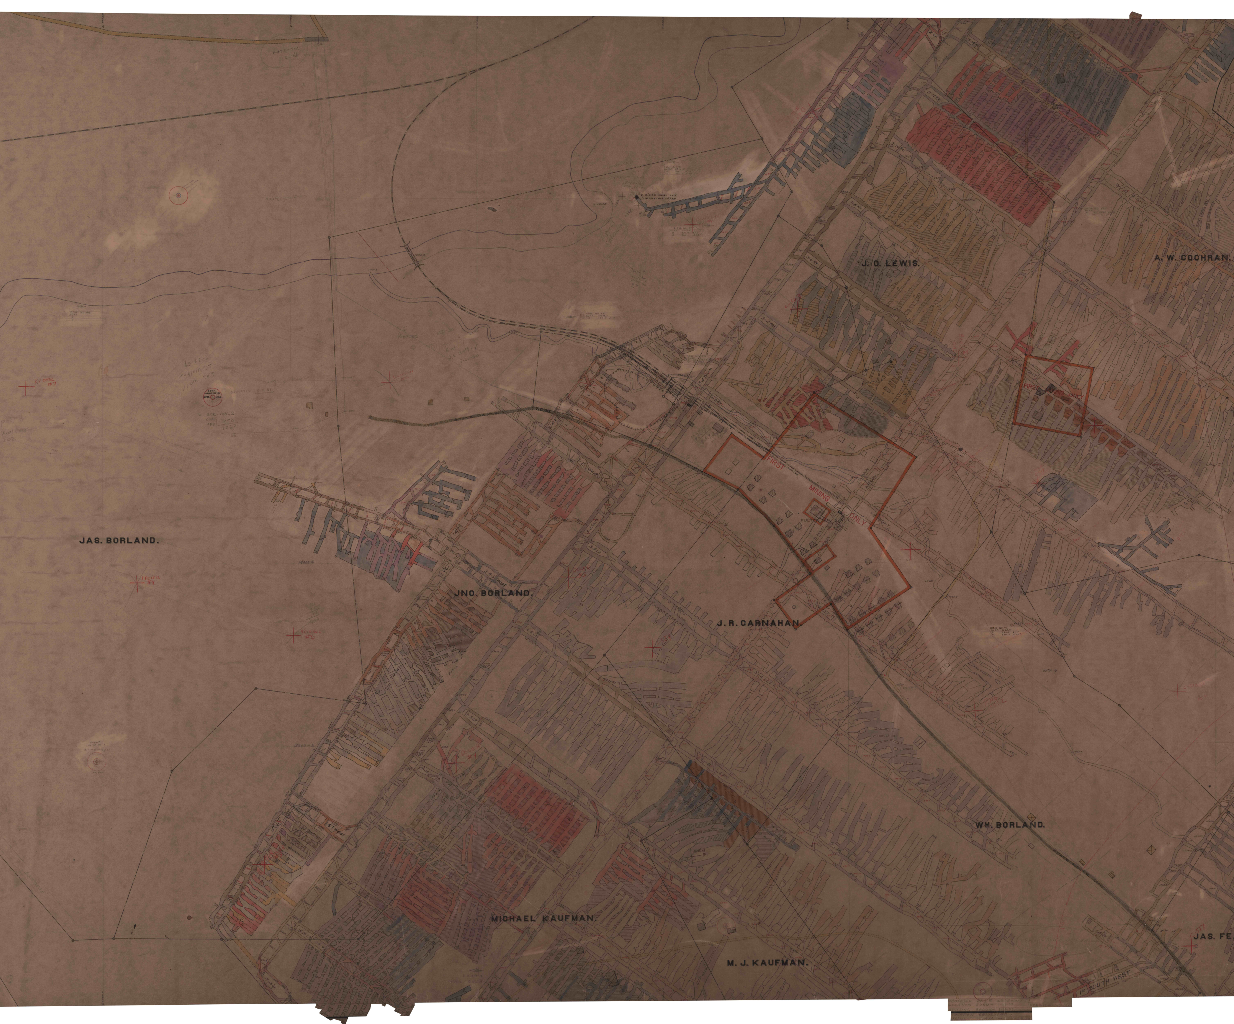
J. O. LEWIS.
A. W. COCHRAN.
FIRST MINING ONLY
FIRST MINING ONLY
N. MAIN AIRWAY
FULTON SUN SHAFT
S. MAIN AIRWAY
JAS. BORLAND.
JNO. BORLAND.
J. R. CARNAHAN.
WM. BORLAND.
MICHAEL KAUFMAN.
M. J. KAUFMAN.
JAS. FE
C-517
1st SOUTH WEST

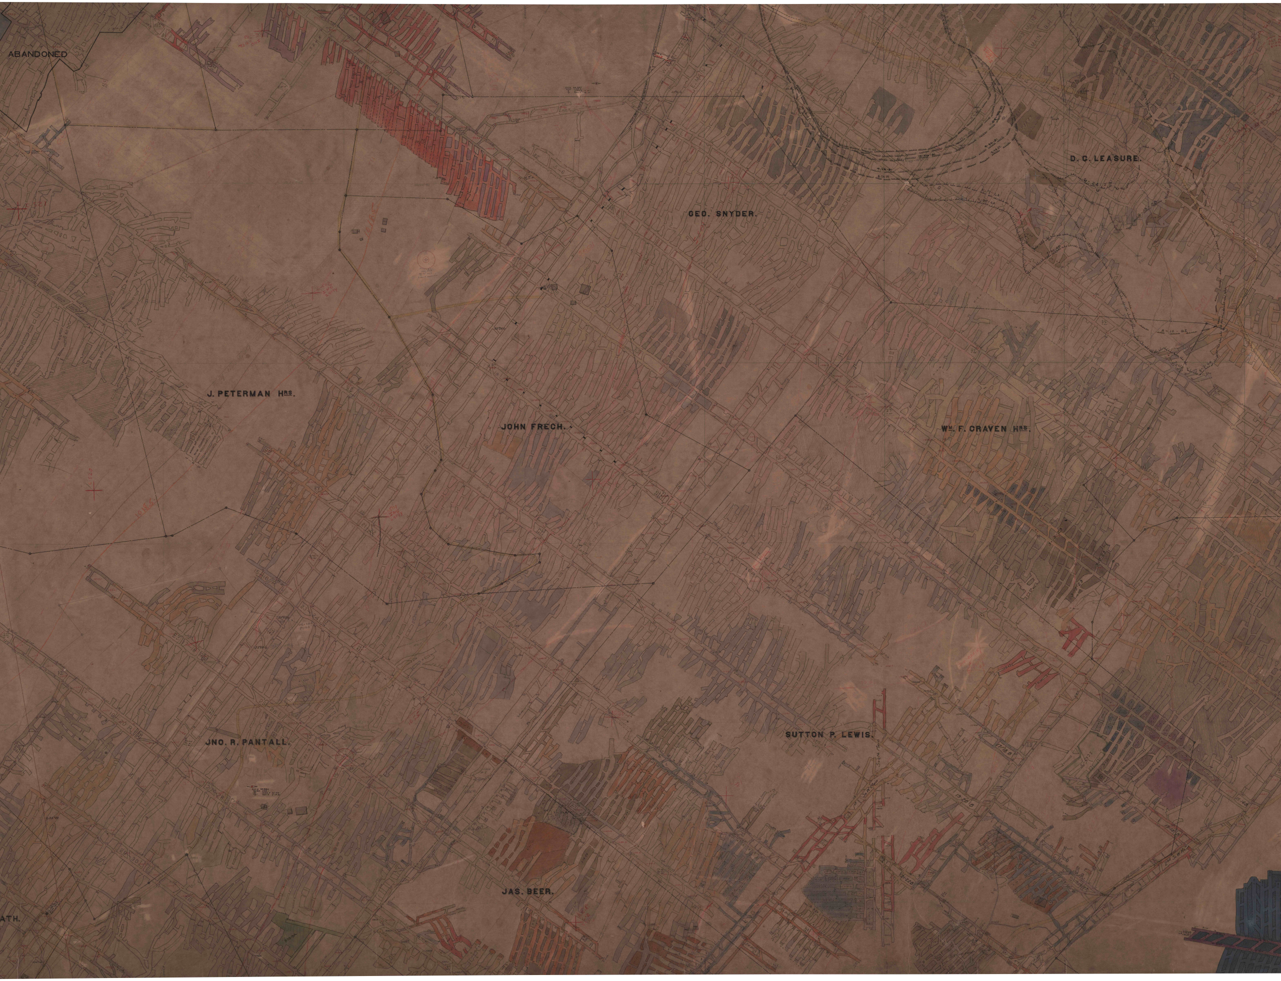
ABANDONED
D. C. LEASURE.
GEO. SNYDER.
J. PETERMAN Hrs.
JOHN FRECH.
Wm. F. CRAVEN Hrs.
JNO. R. PANTALL.
SUTTON P. LEWIS.
JAS. BEER.
ATH.

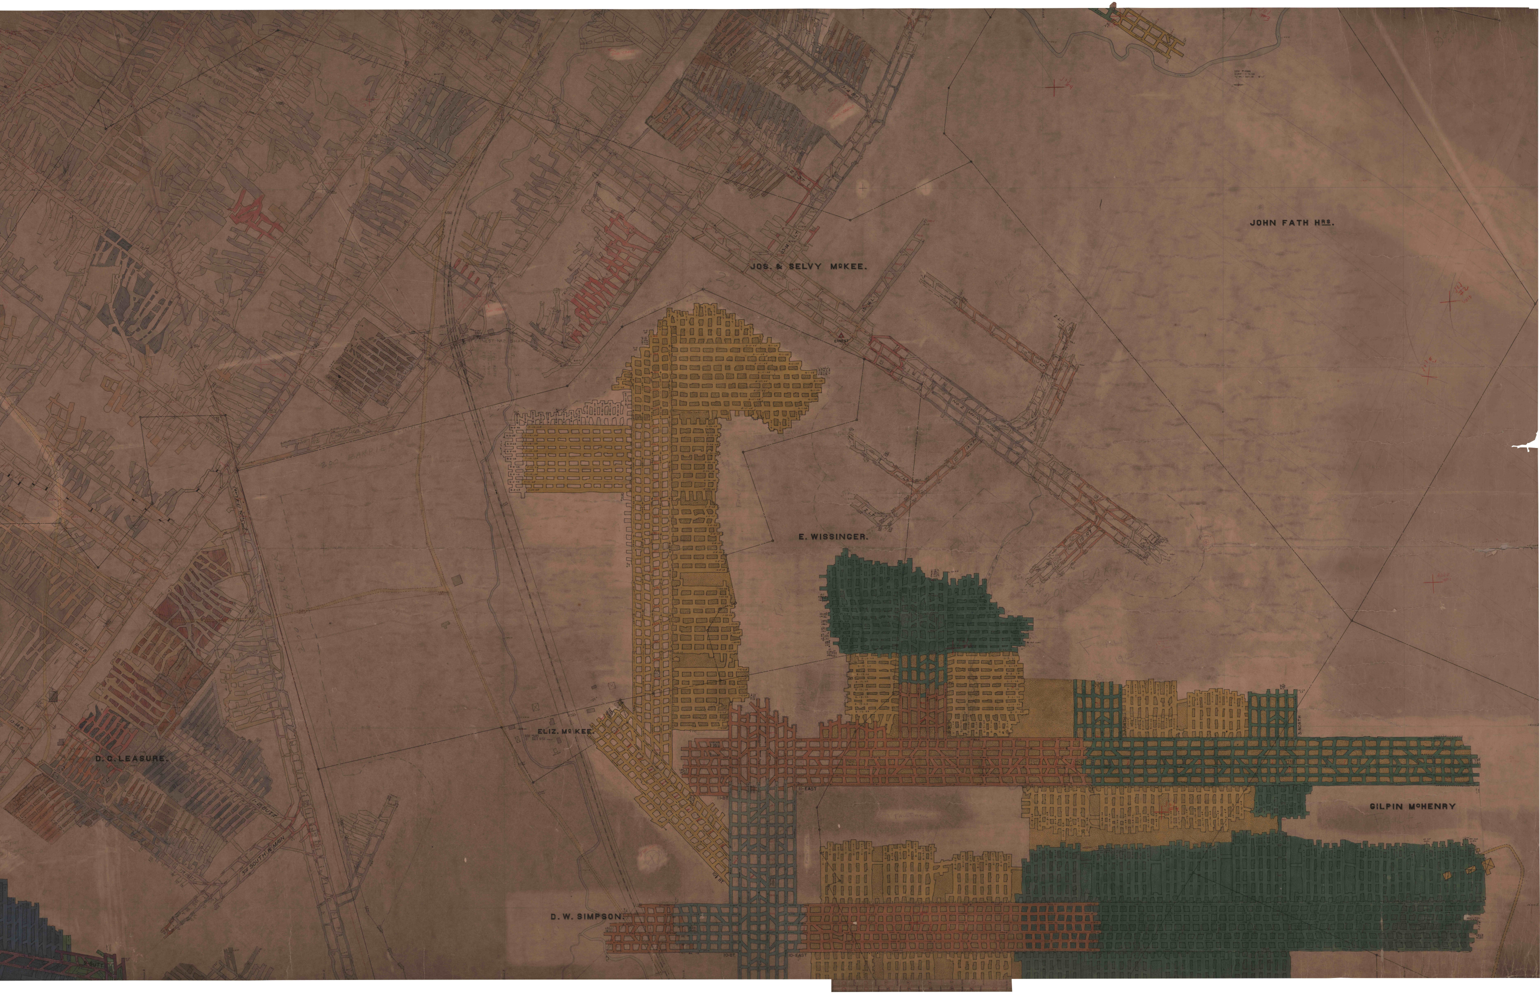
JOHN FATH Hrs.
JOS. & SELVY McKEE.
E. WISSINGER.
ELIZ. McKEE.
D. C. LEASURE.
GILPIN McHENRY
D. W. SIMPSON.