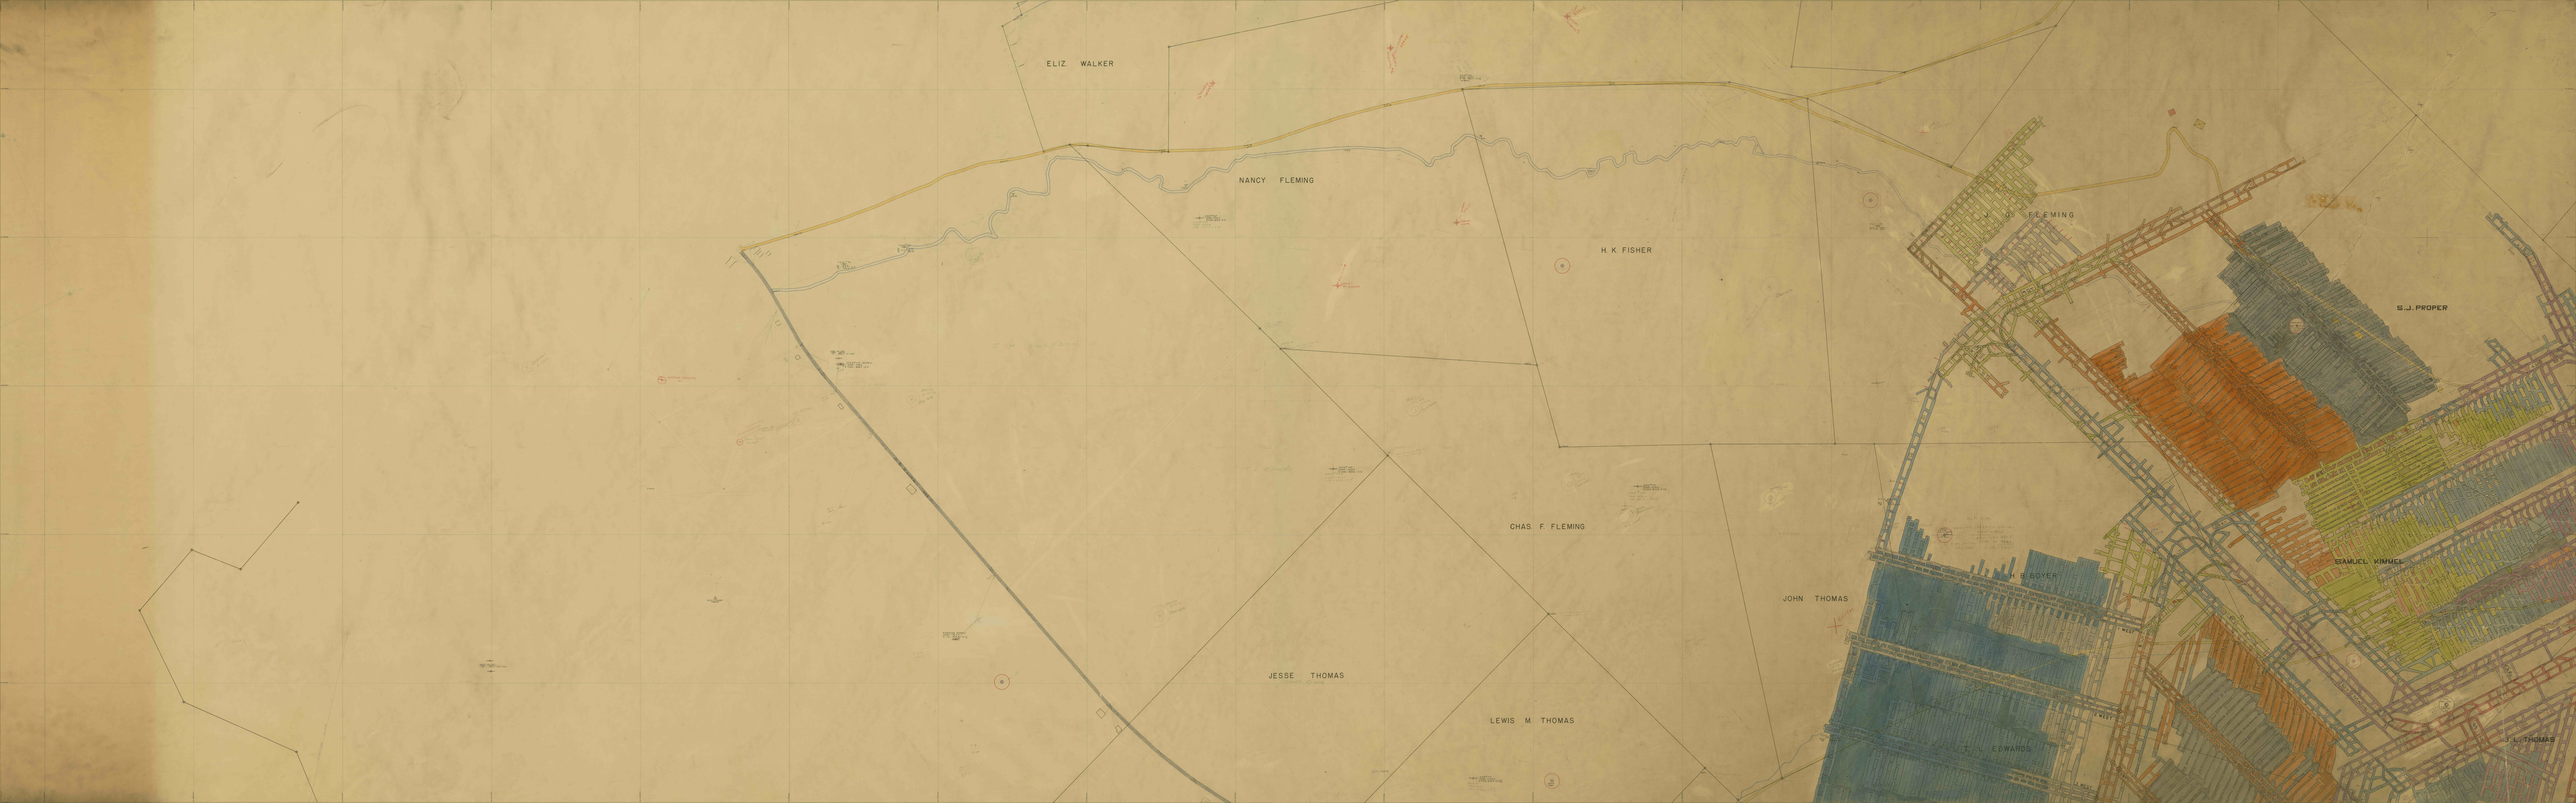
ELIZ. WALKER
NANCY FLEMING
H. K. FISHER
CHAS. F. FLEMING
JOHN THOMAS
JESSE THOMAS
LEWIS M. THOMAS
S. J. PROPER
SAMUEL KIMMEL
J. L. THOMAS