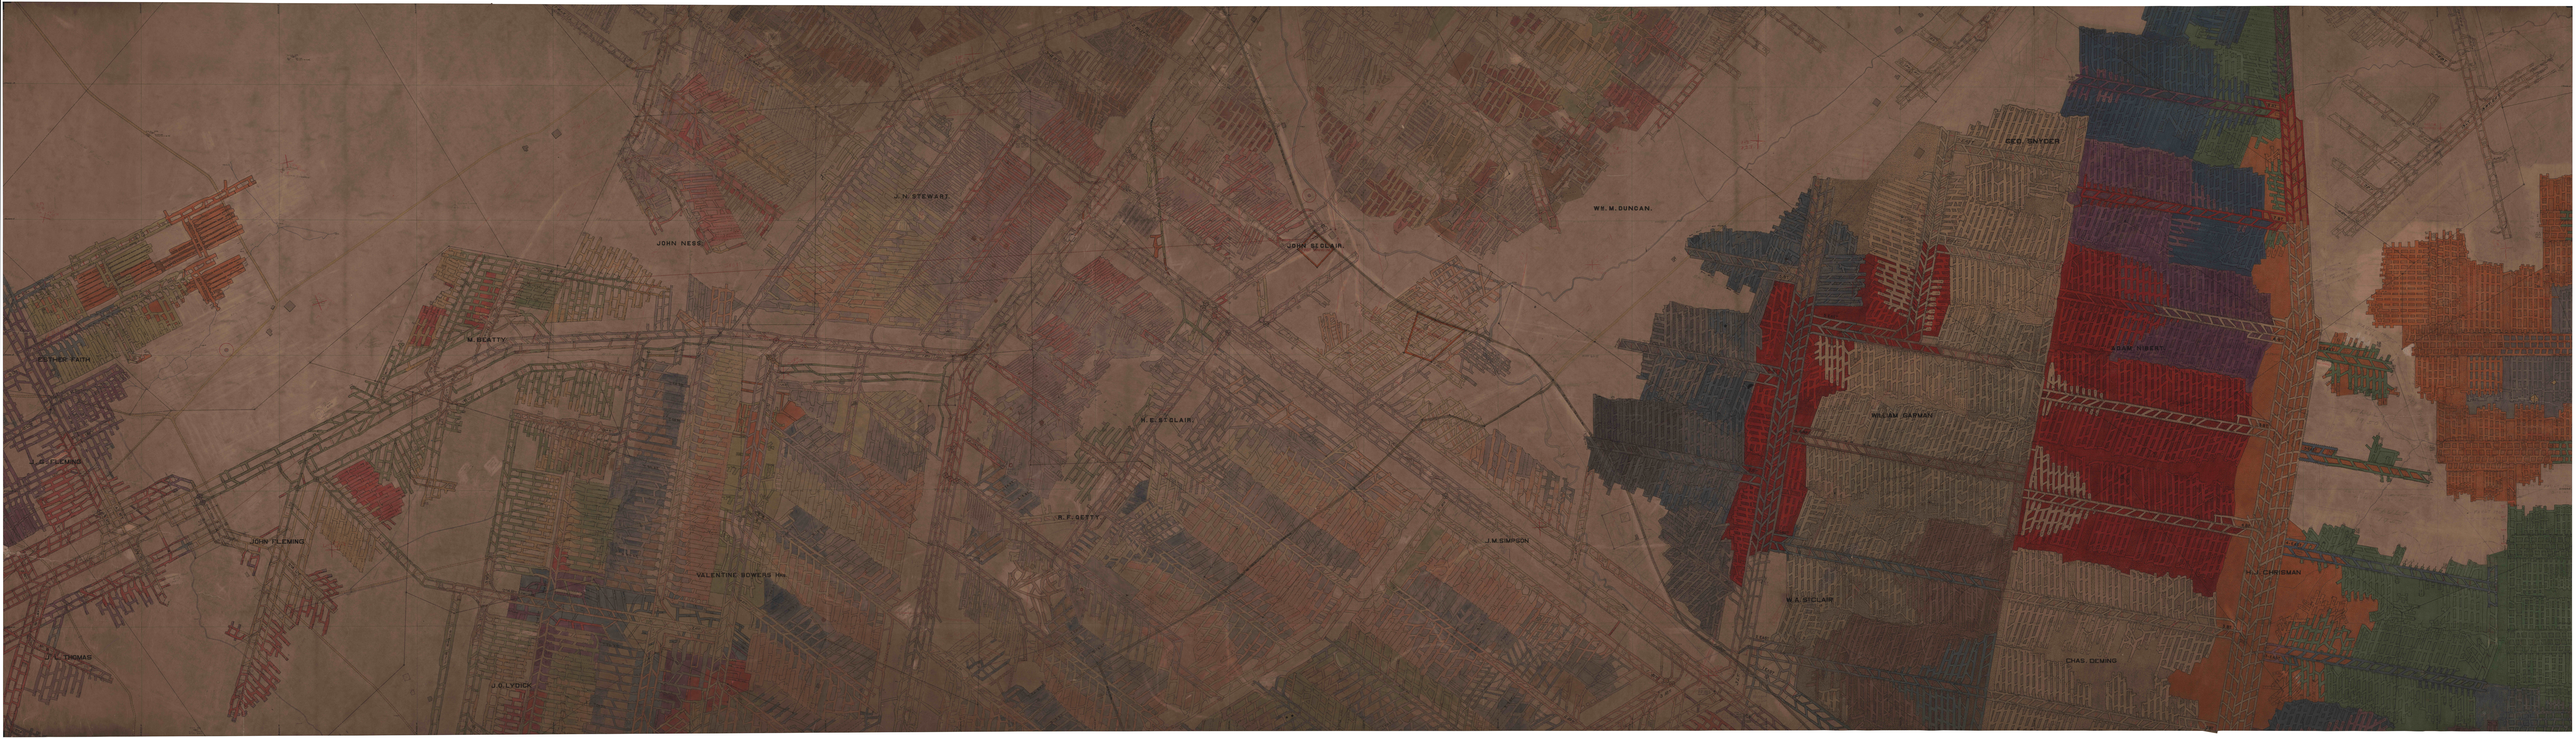
ESTHER FAITH
J.P. CHEVNEY
J.W. THOMAS
JOHN FLEMING
M. BEATTY
JOHN NESS
J.G. LYDICK
J.N. STEWART
VALENTINE BOWERS Hrs.
JOHN SECLAIR
H.E. SECLAIR
R.F. GETTY
J.M. SIMPSON
WM. M. DUNCAN.
WILLIAM CARMAN
W.A. SECLAIR
GEO. SNYDER
ADAM HIBERT
CHAS. DEMING
H.L. CHRISMAN