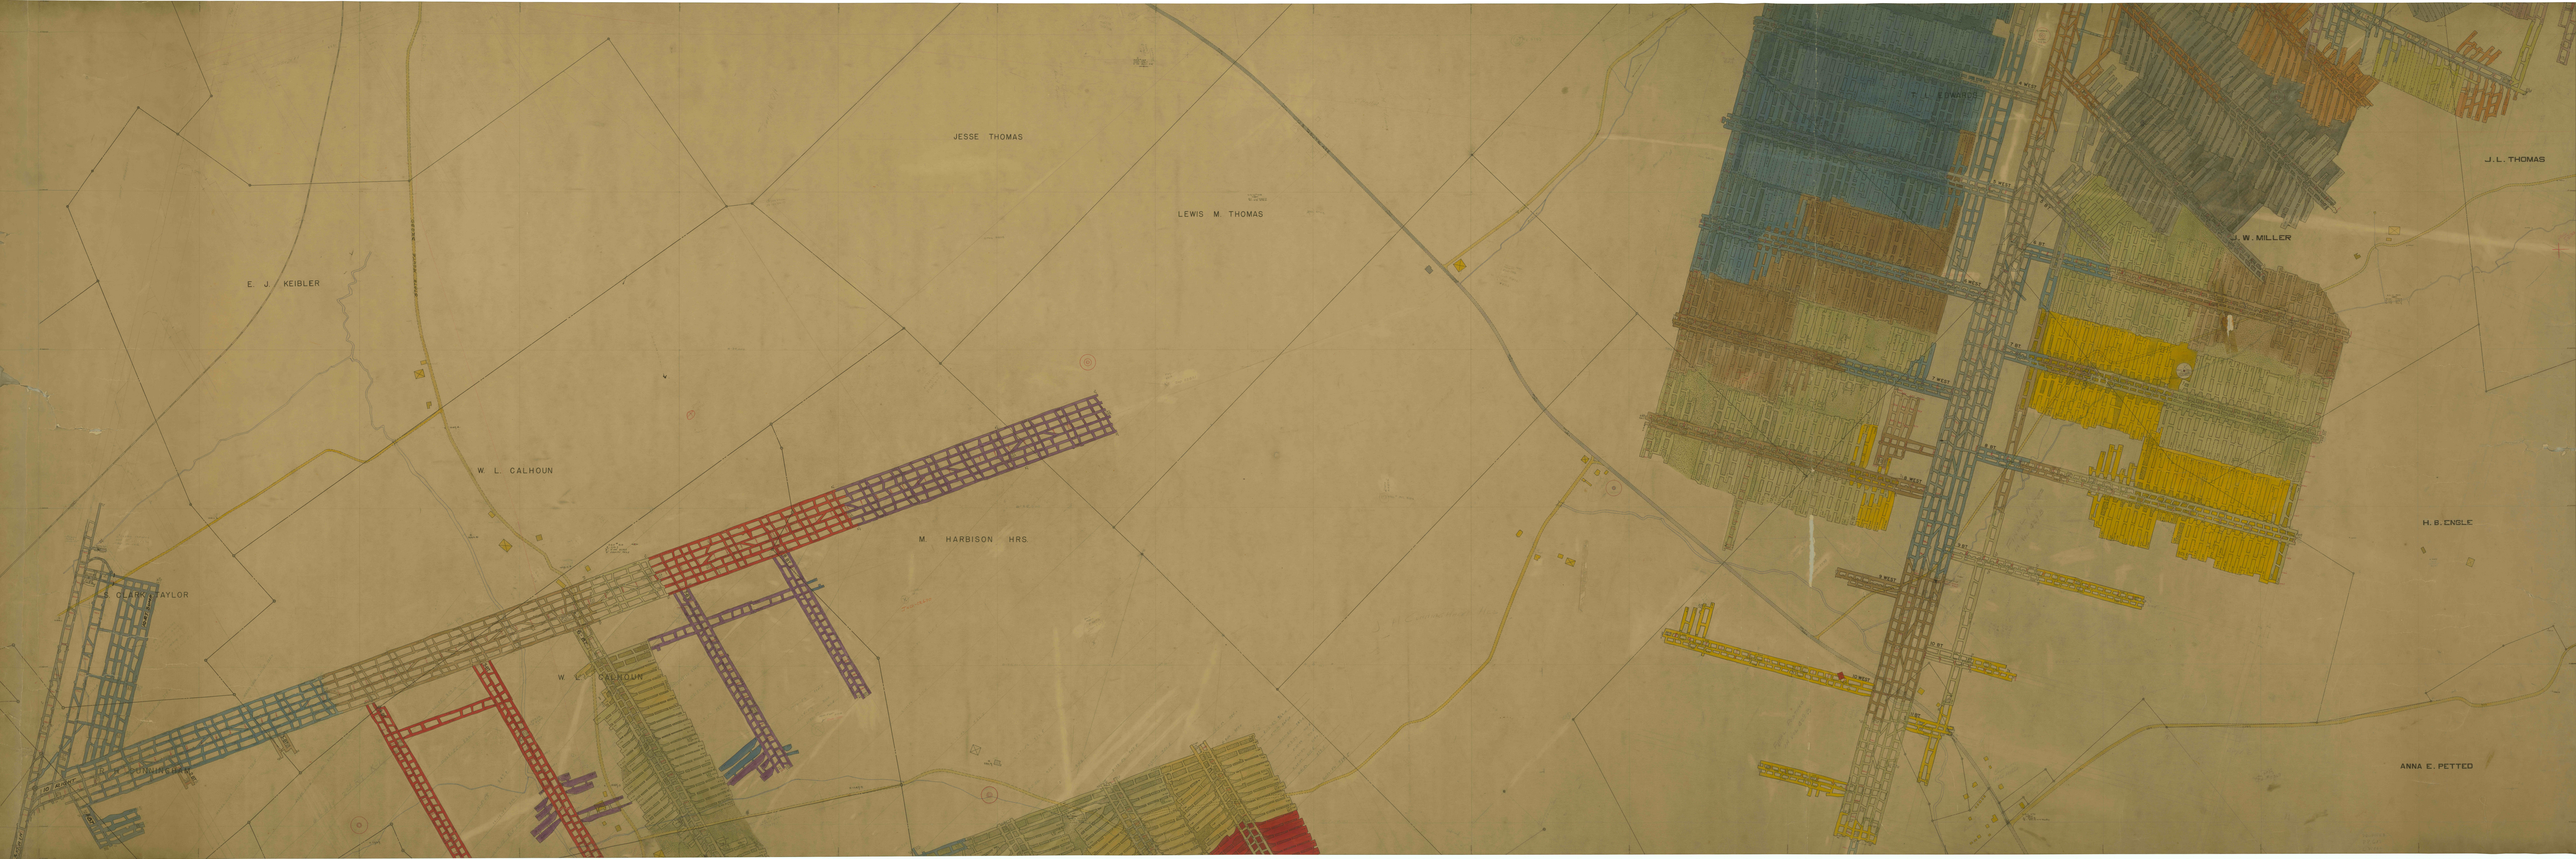
JESSE THOMAS
LEWIS M. THOMAS
E. J. KEIBLER
W. L. CALHOUN
M. HARBISON HRS.
S. CLARK TAYLOR
W. C. CALHOUN
J. L. THOMAS
J. W. MILLER
H. B. ENGLE
ANNA E. PETTED