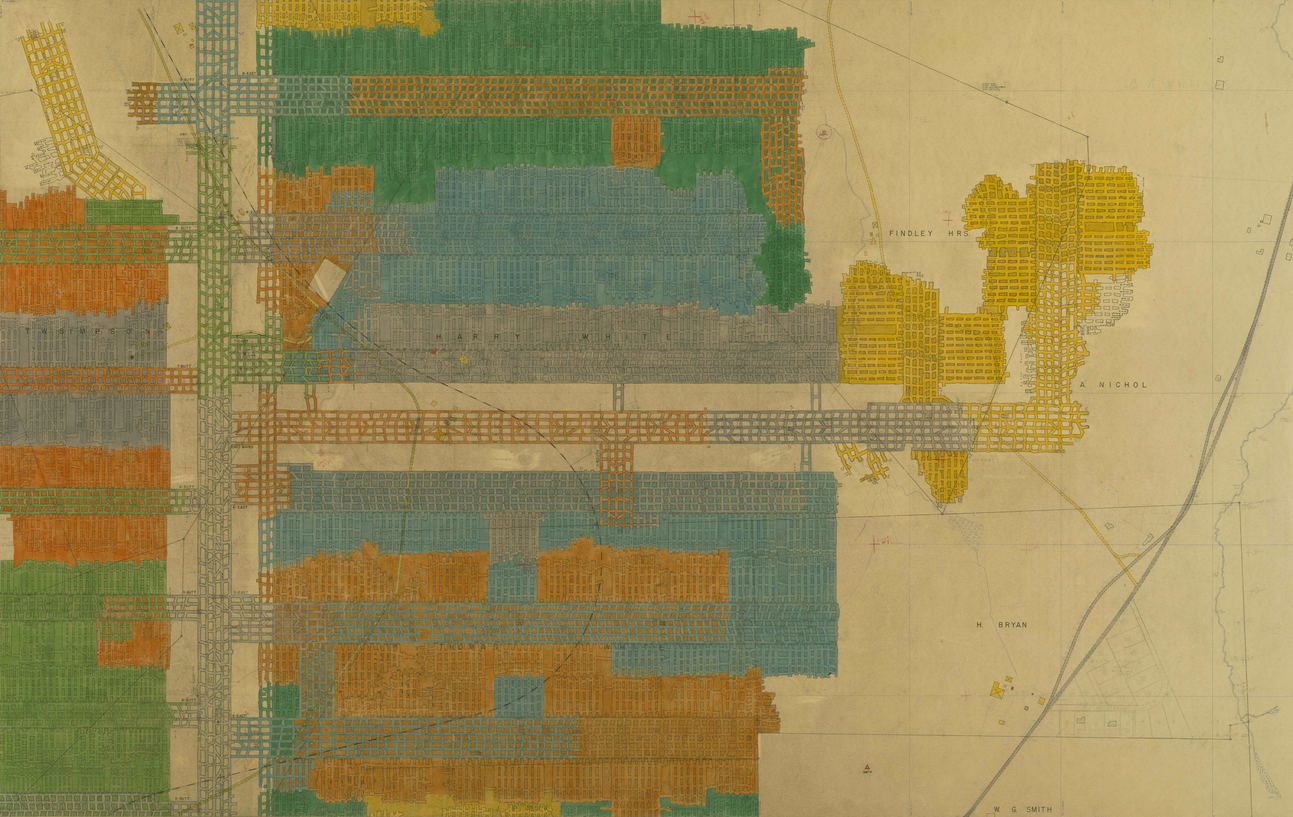
FINDLEY HRS
A. NICHOL
H. BRYAN
W. G. SMITH