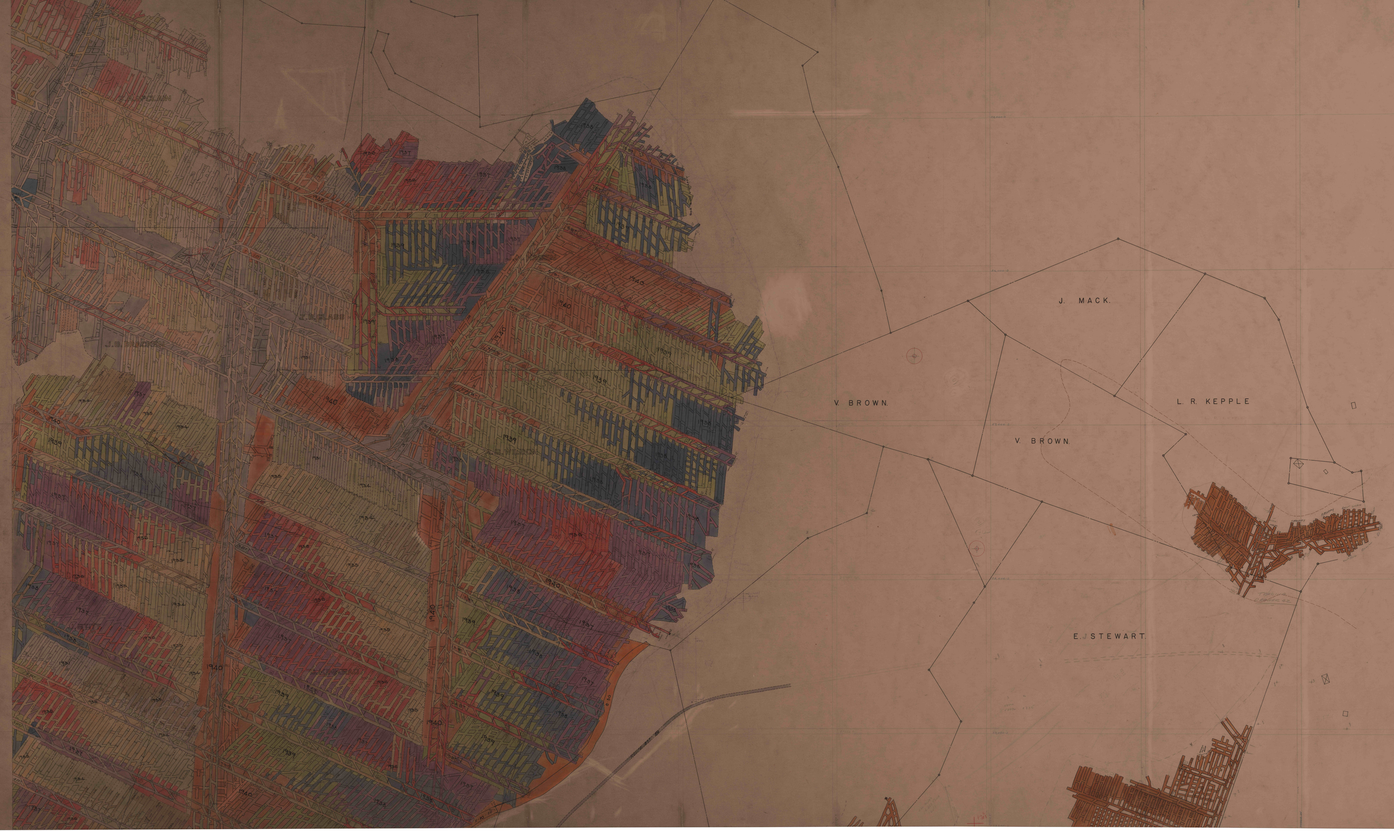
J. MACK.
V. BROWN.
L. R. KEPPLE
V. BROWN.
E. J. STEWART