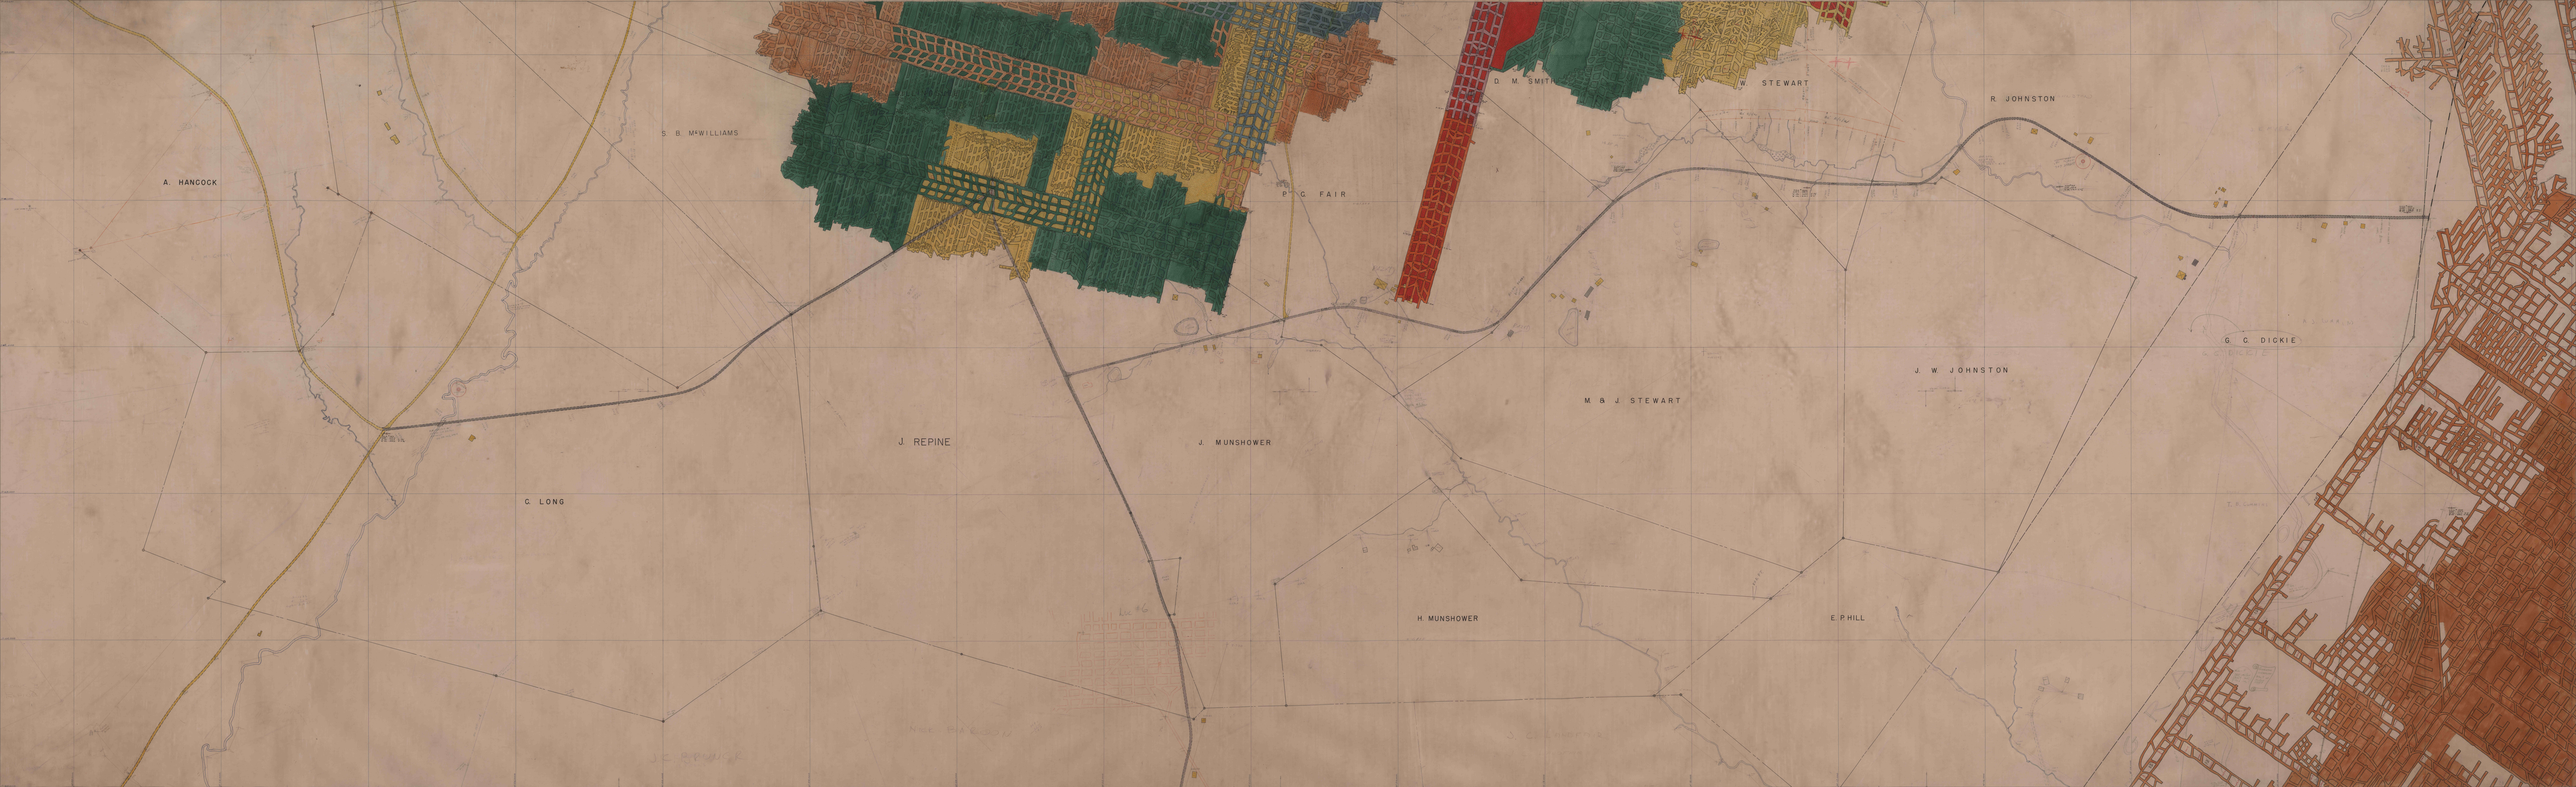
A. HANCOCK
S. B. McWILLIAMS
P. C. FAIR
D. M. SMITH
W. STEWART
R. JOHNSTON
G. C. DICKIE
J. W. JOHNSTON
M. & J. STEWART
J. REPINE
J. MUNSHOWER
C. LONG
H. MUNSHOWER
E. P. HILL