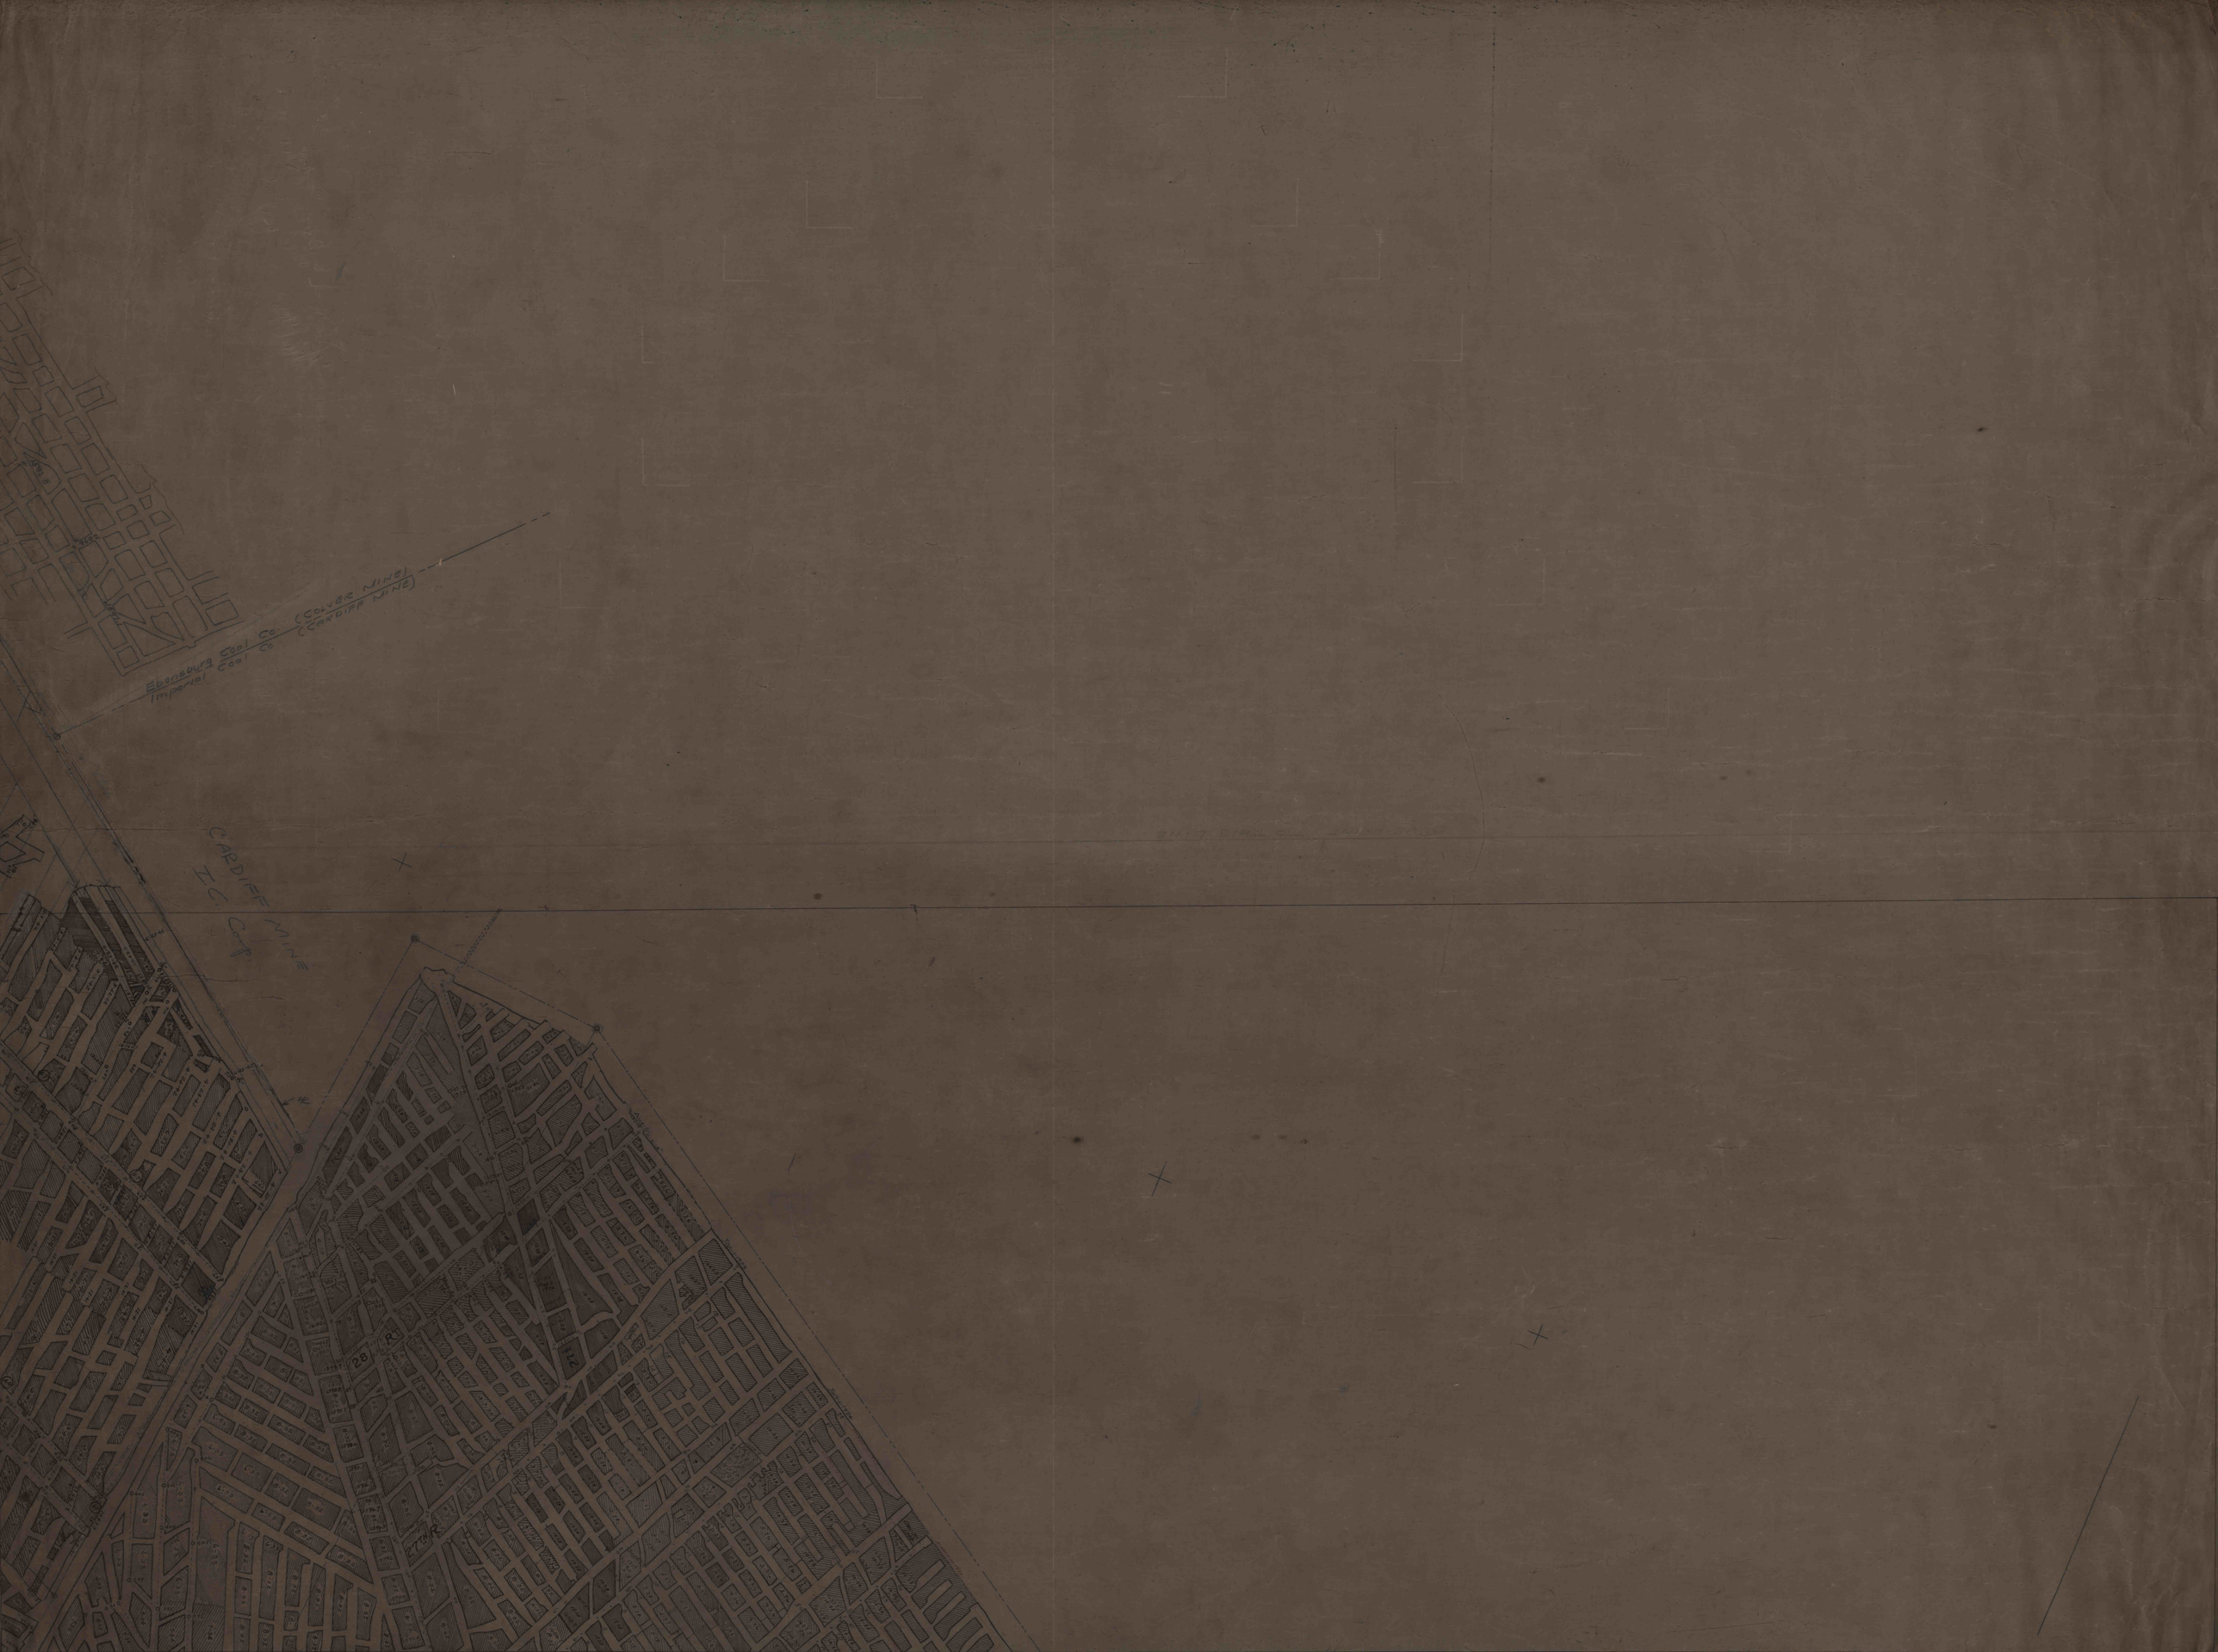
Ebensburg Coal Co. (Colver Mine)
Imperial Coal Co. (Cardiff Mine)
Cardiff Mine
I.C. Corp.
28 R
27 R