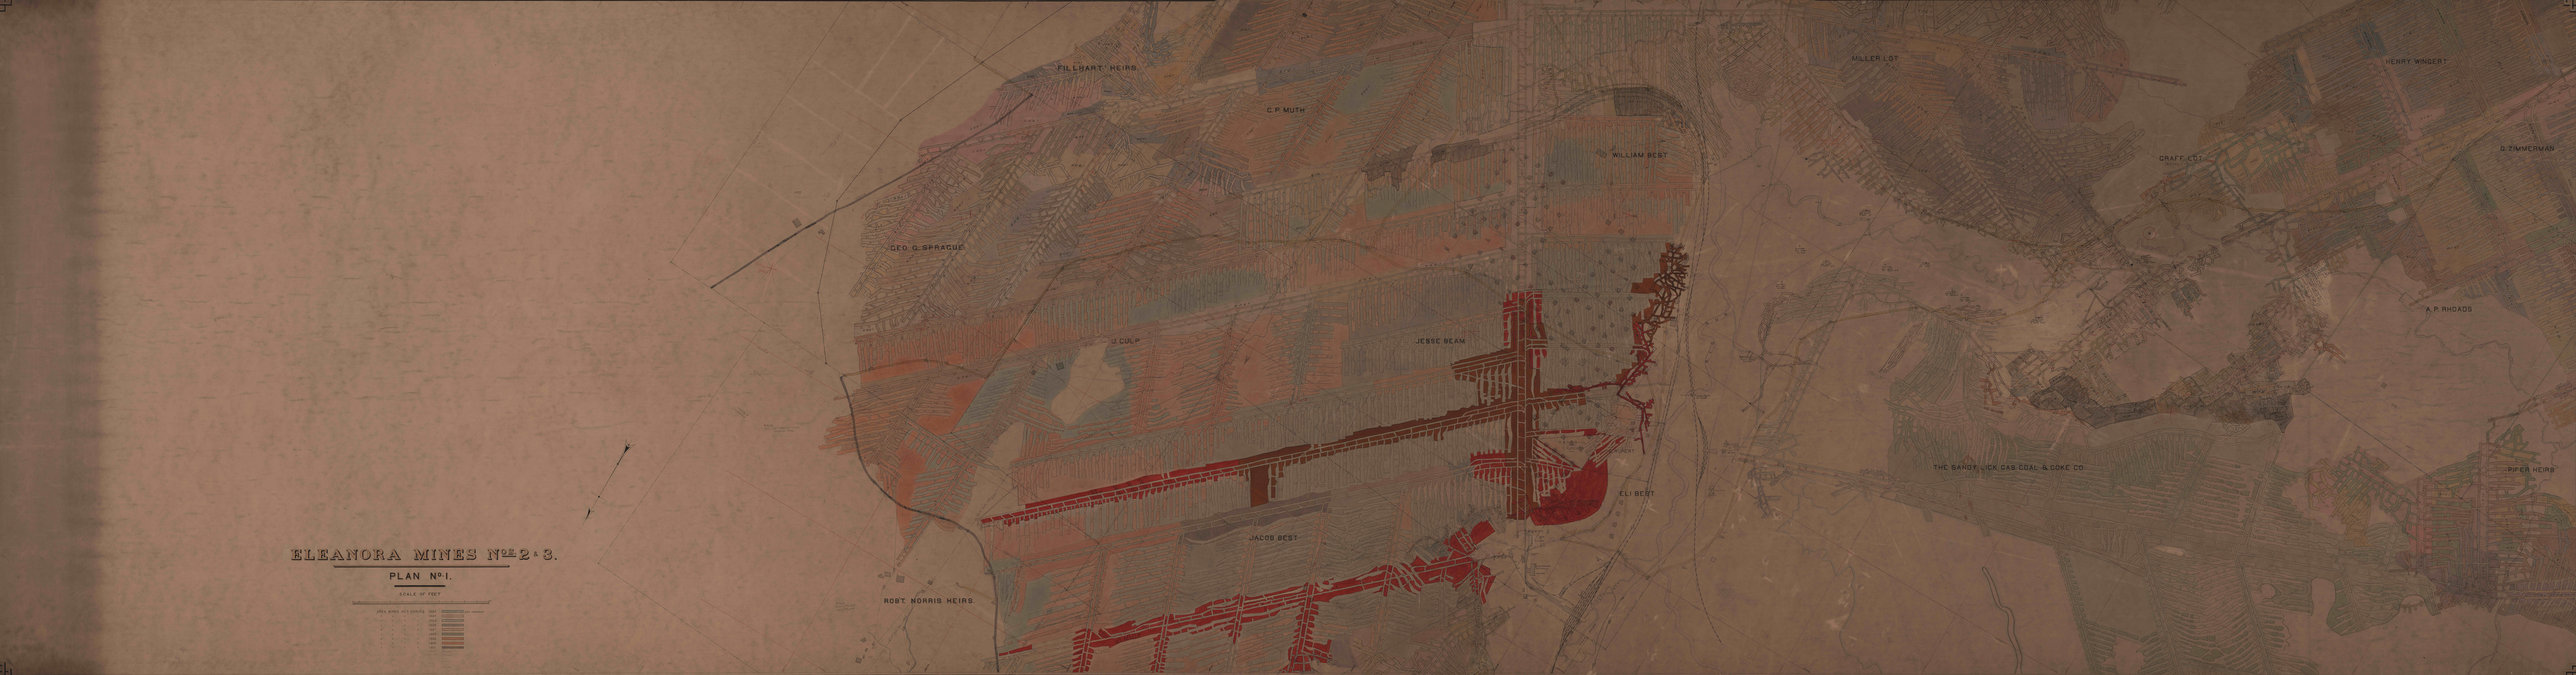

ELEANORA MINES Nos. 2 & 3.

PLAN No. 1.

SCALE OF FEET