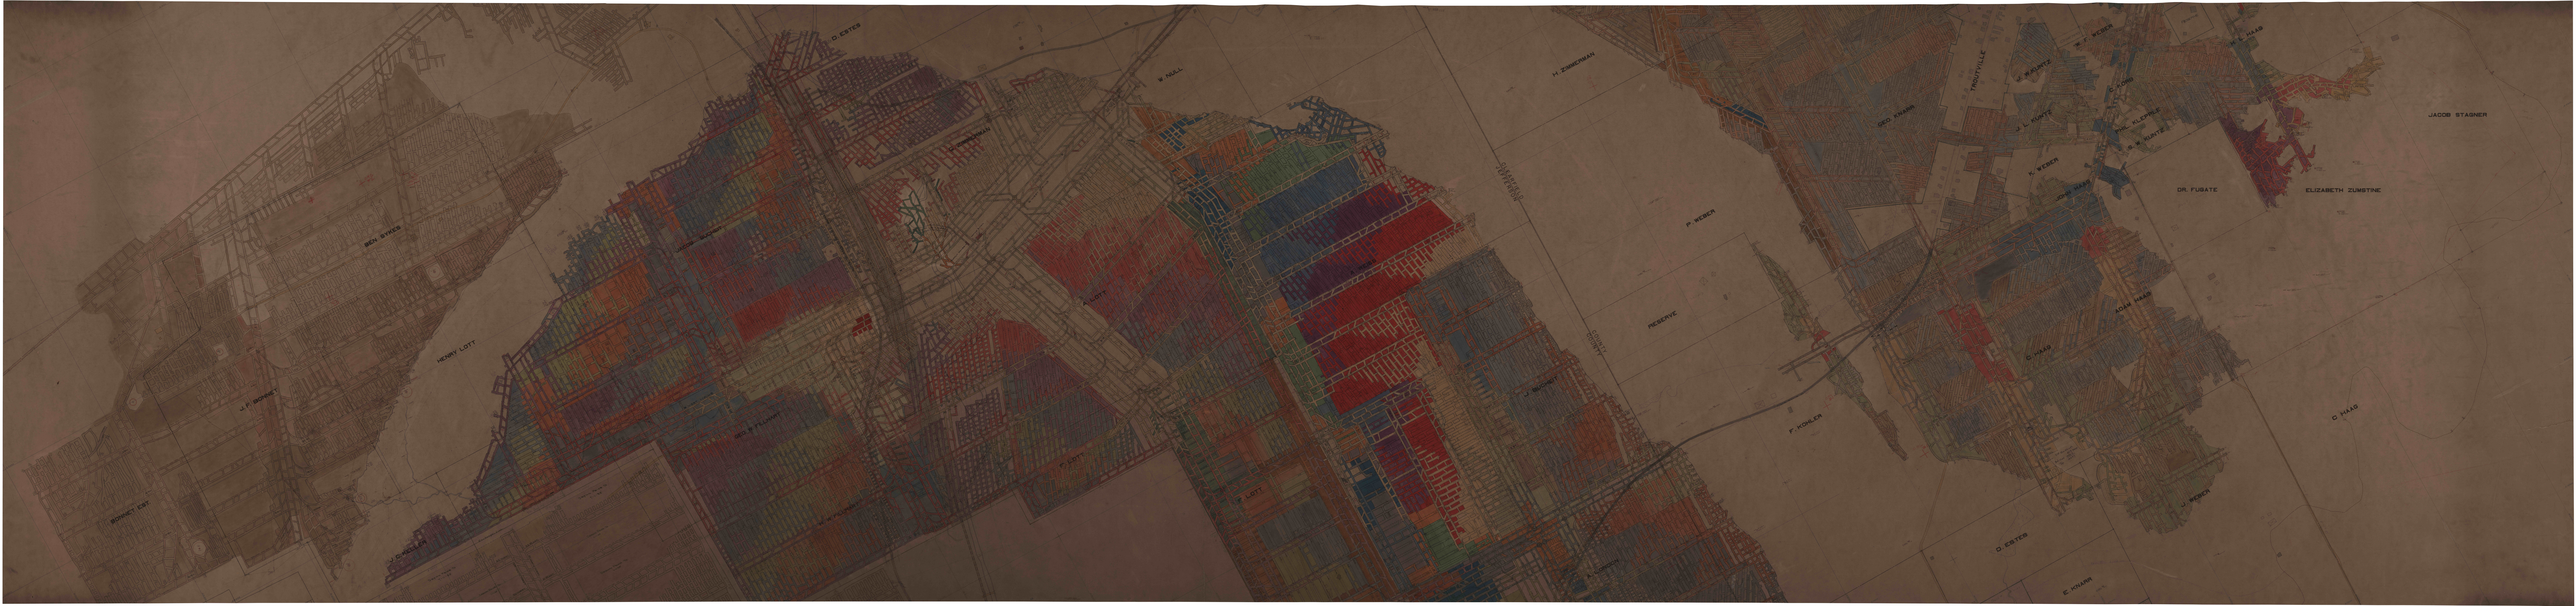
D. ESTES
W. HULL
H. ZIMMERMAN
BEN. SYKES
HENRY LOTT
J. F. BONNET
BONNET EST.
J. CHESLER
P. WEBER
RESERVE
F. KOHLER
GEO. KRAMB
TROUTVILLE
J. L. KUNTZ
P. WEBER
DR. FUGATE
ELIZABETH ZUMSTINE
JACOB STAGNER
C. HAAS
E. KRAMB