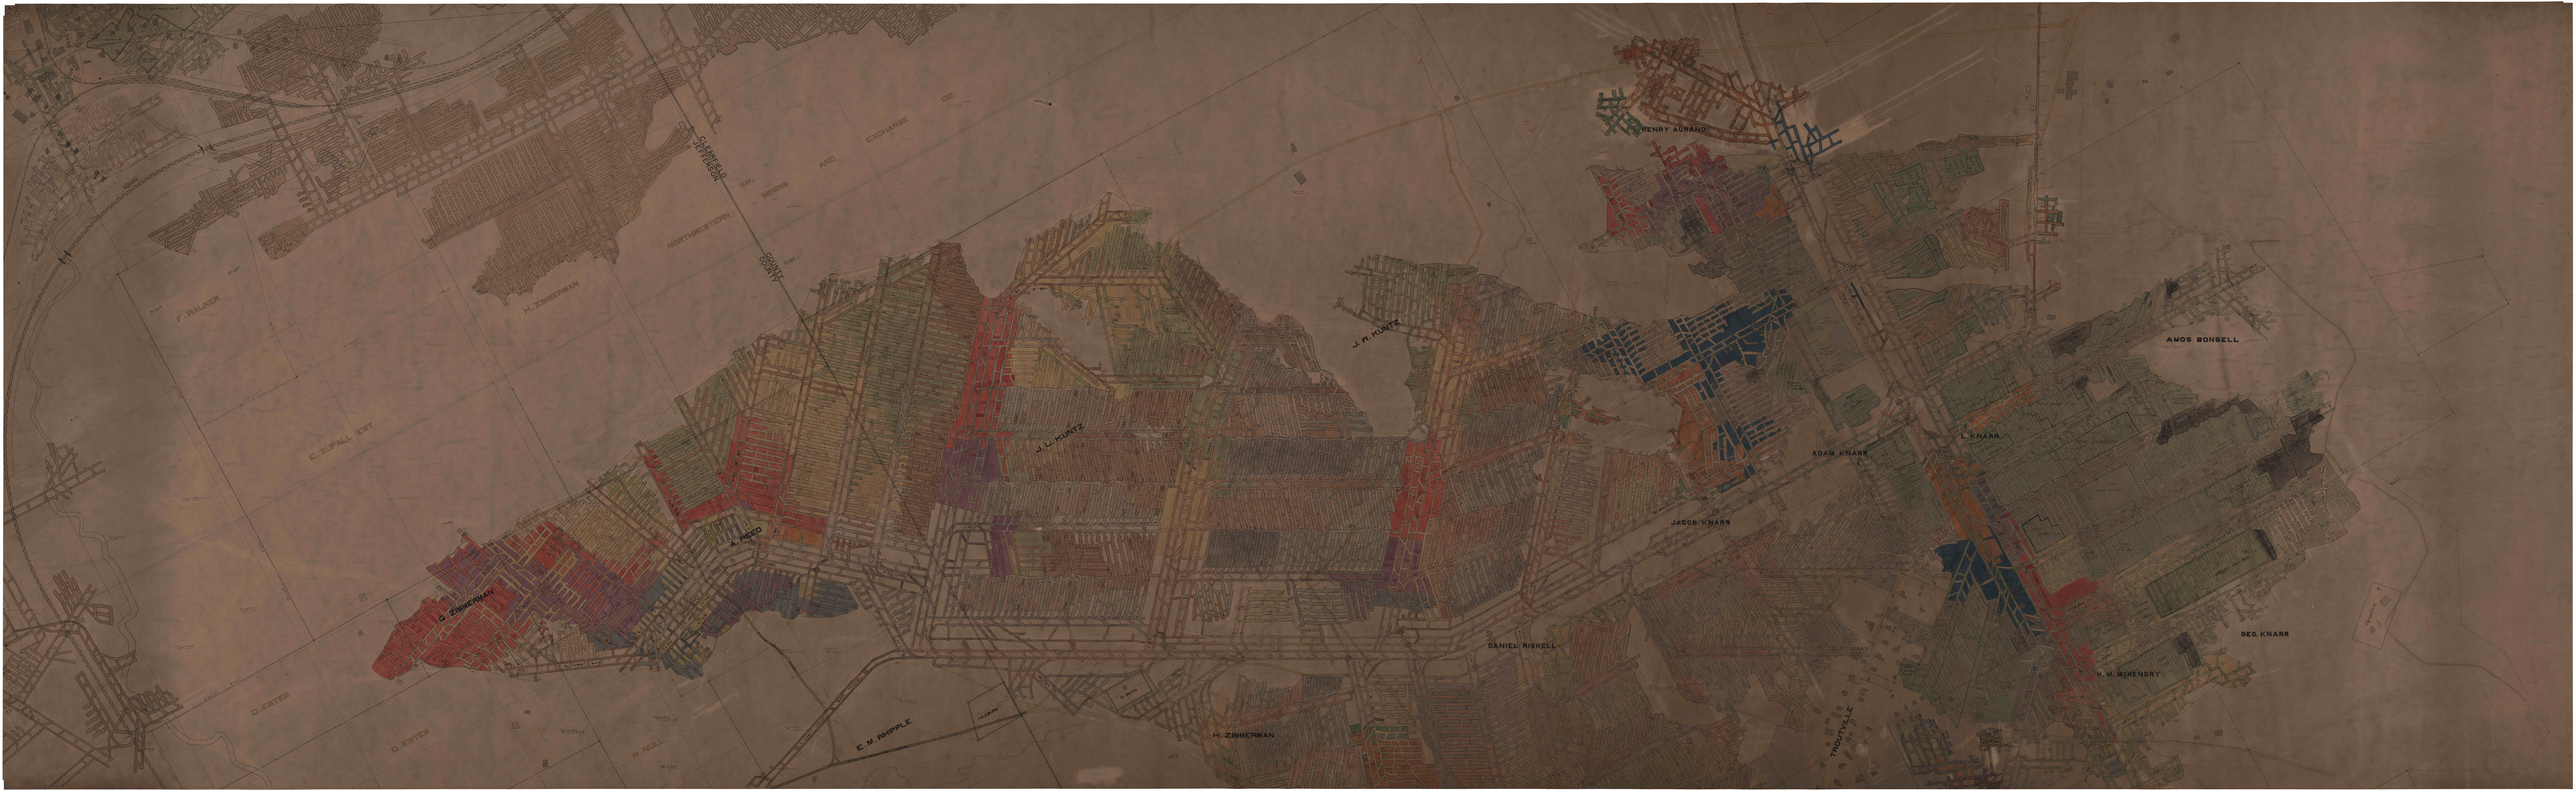

HENRY AURAND
AMOS BONSELL
J. W. KUNTZ
J. L. KUNTZ
ADAM KNARR
L. KNARR
JACOB KNARR
A. REED
G. ZIMMERMAN
DANIEL RISHELL
GEO. KNARR
H. M. McHENDRY
H. ZIMMERMAN
E. M. WHIPPLE
TROUTVILLE
F. WALKER
H. ZIMMERMAN
E. ZUFALL EST
D. ESTES
D. ESTES
W. NULL
NORTHWESTERN
MINING AND EXCHANGE CO
COUNTY
COUNTY