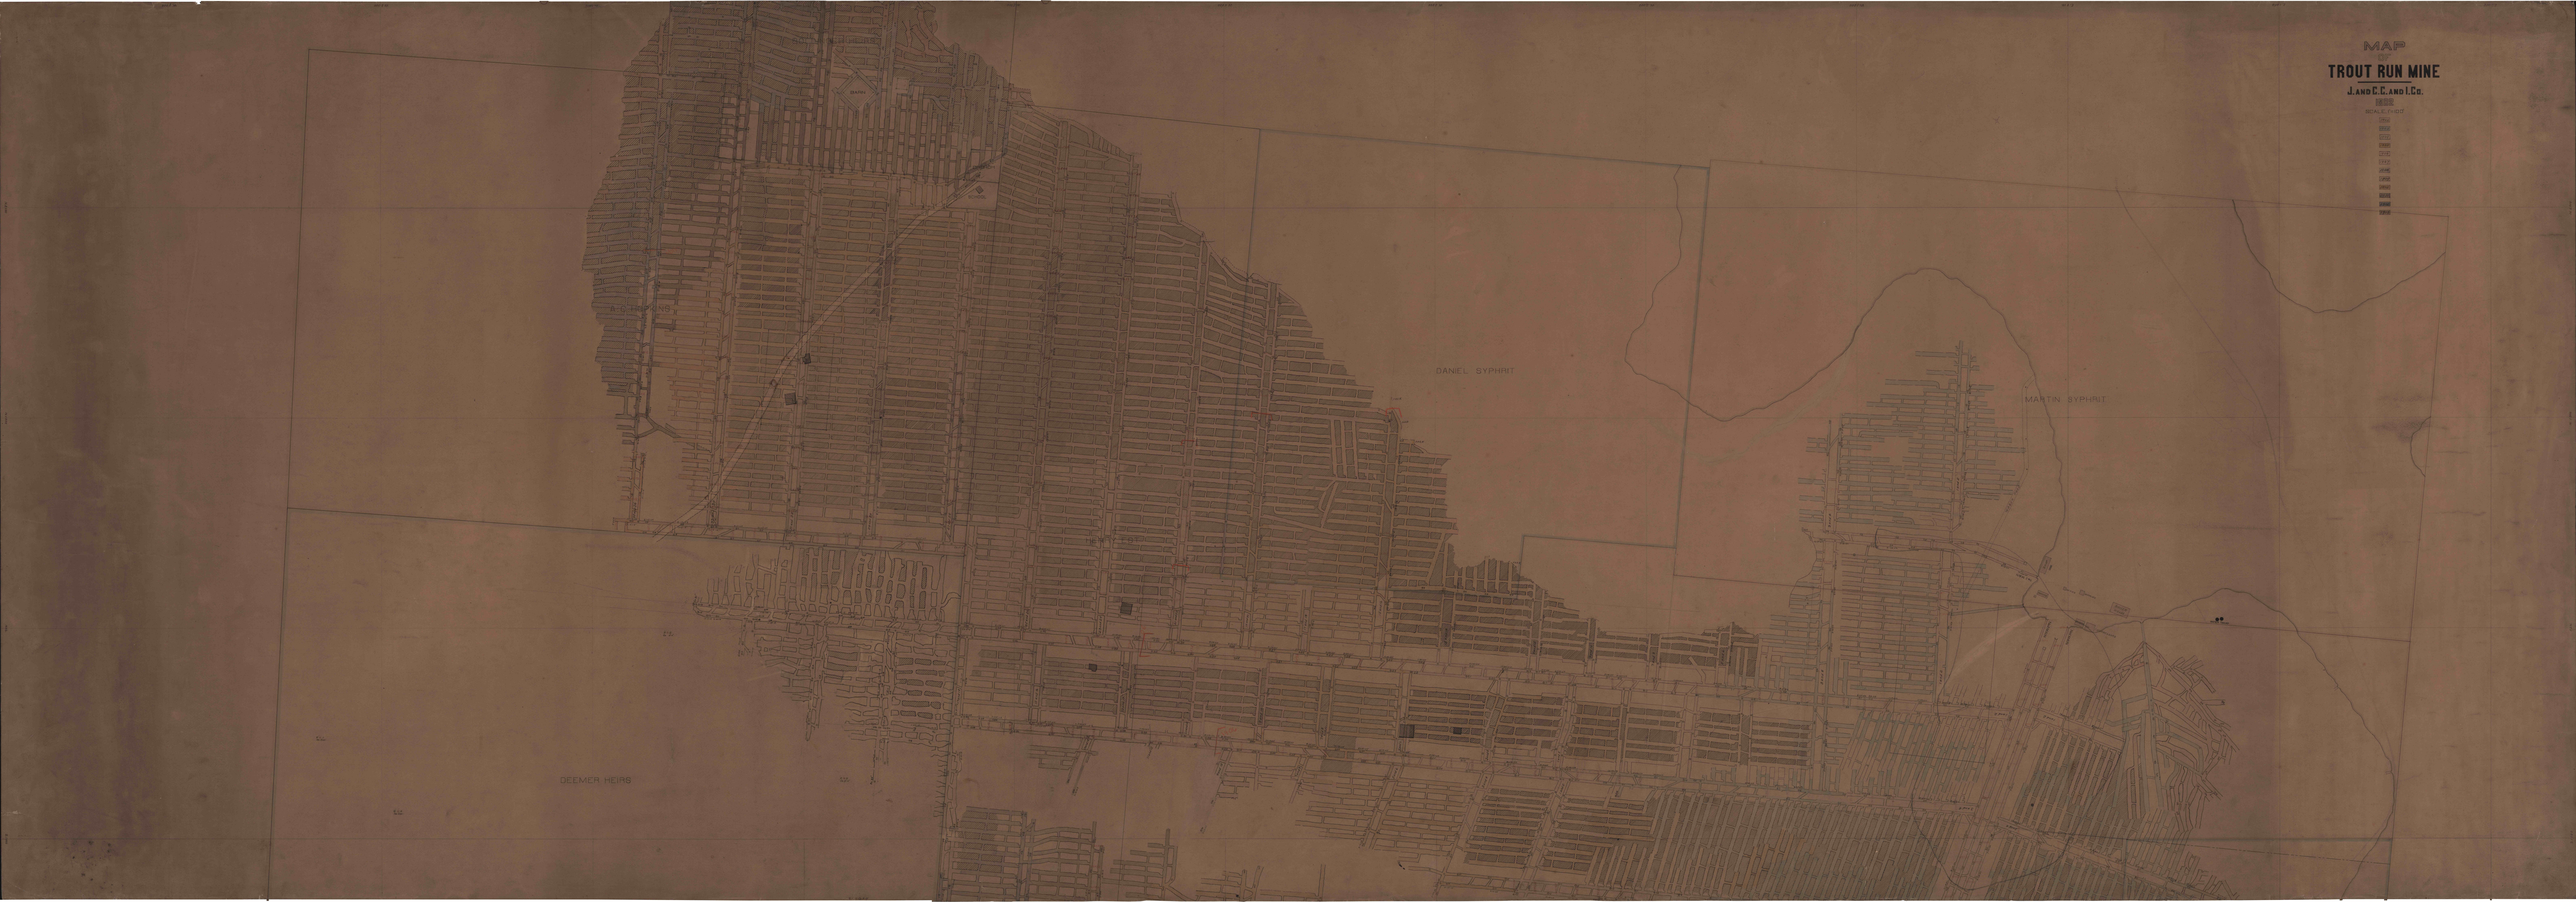
MAP
TROUT RUN MINE
J. AND C. C. AND I. CO.
SCALE 1 INCH
DANIEL SYPHRIT
MARTIN SYPHRIT
DEEMER HEIRS