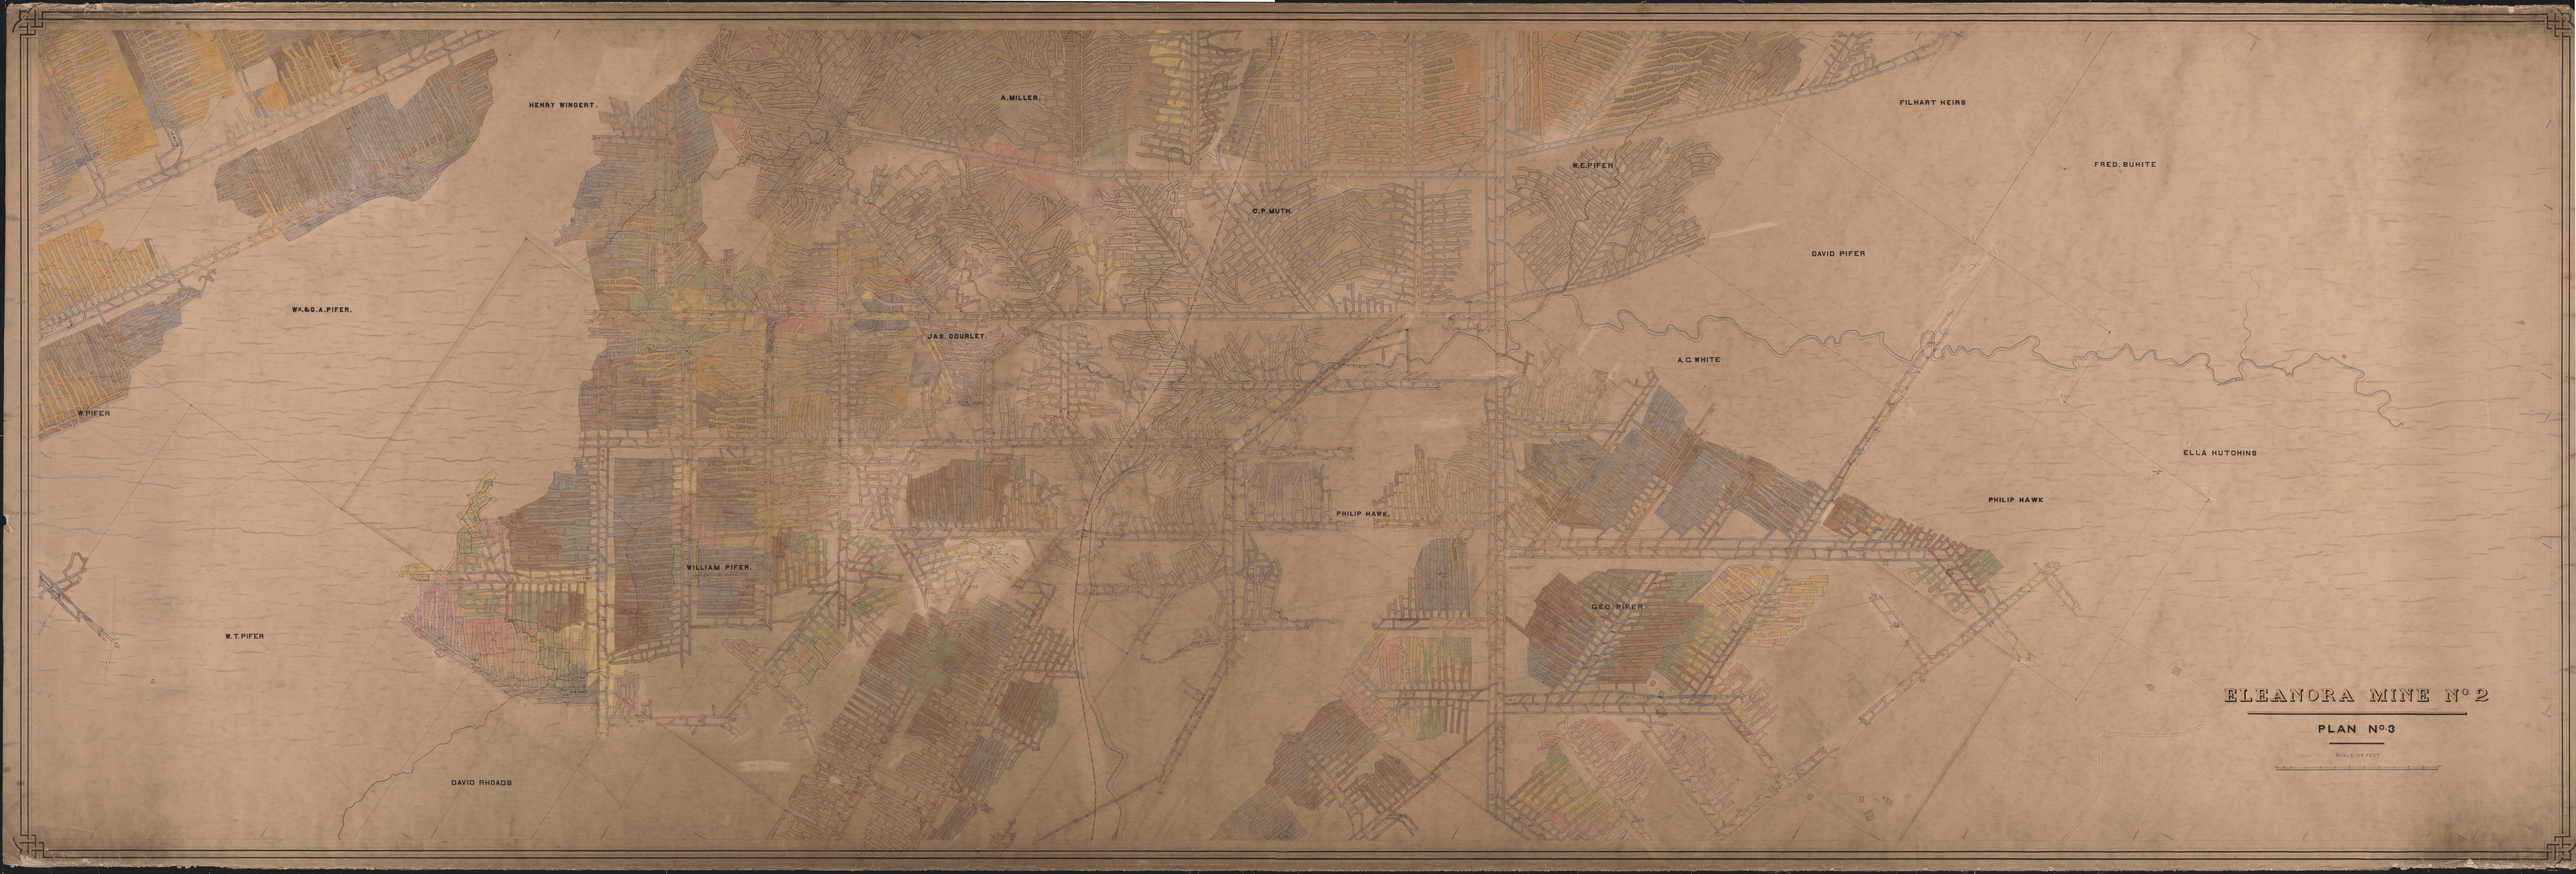
HENRY WINDERT.
A. MILLER.
FILHART HEIRS
W.E. PIFER
FRED. BUHITE
C.P. MUTH.
DAVID PIFER
WM. & G.A. PIFER.
JAS. COURLEY.
A.C. WHITE
W. PIFER
ELLA HUTCHINS
PHILIP HAWK.
PHILIP HAWK
WILLIAM PIFER.
GEO. PIFER
W.T. PIFER
DAVID RHOADS
ELEANORA MINE Nº 2
PLAN Nº 3
SCALE OF FEET