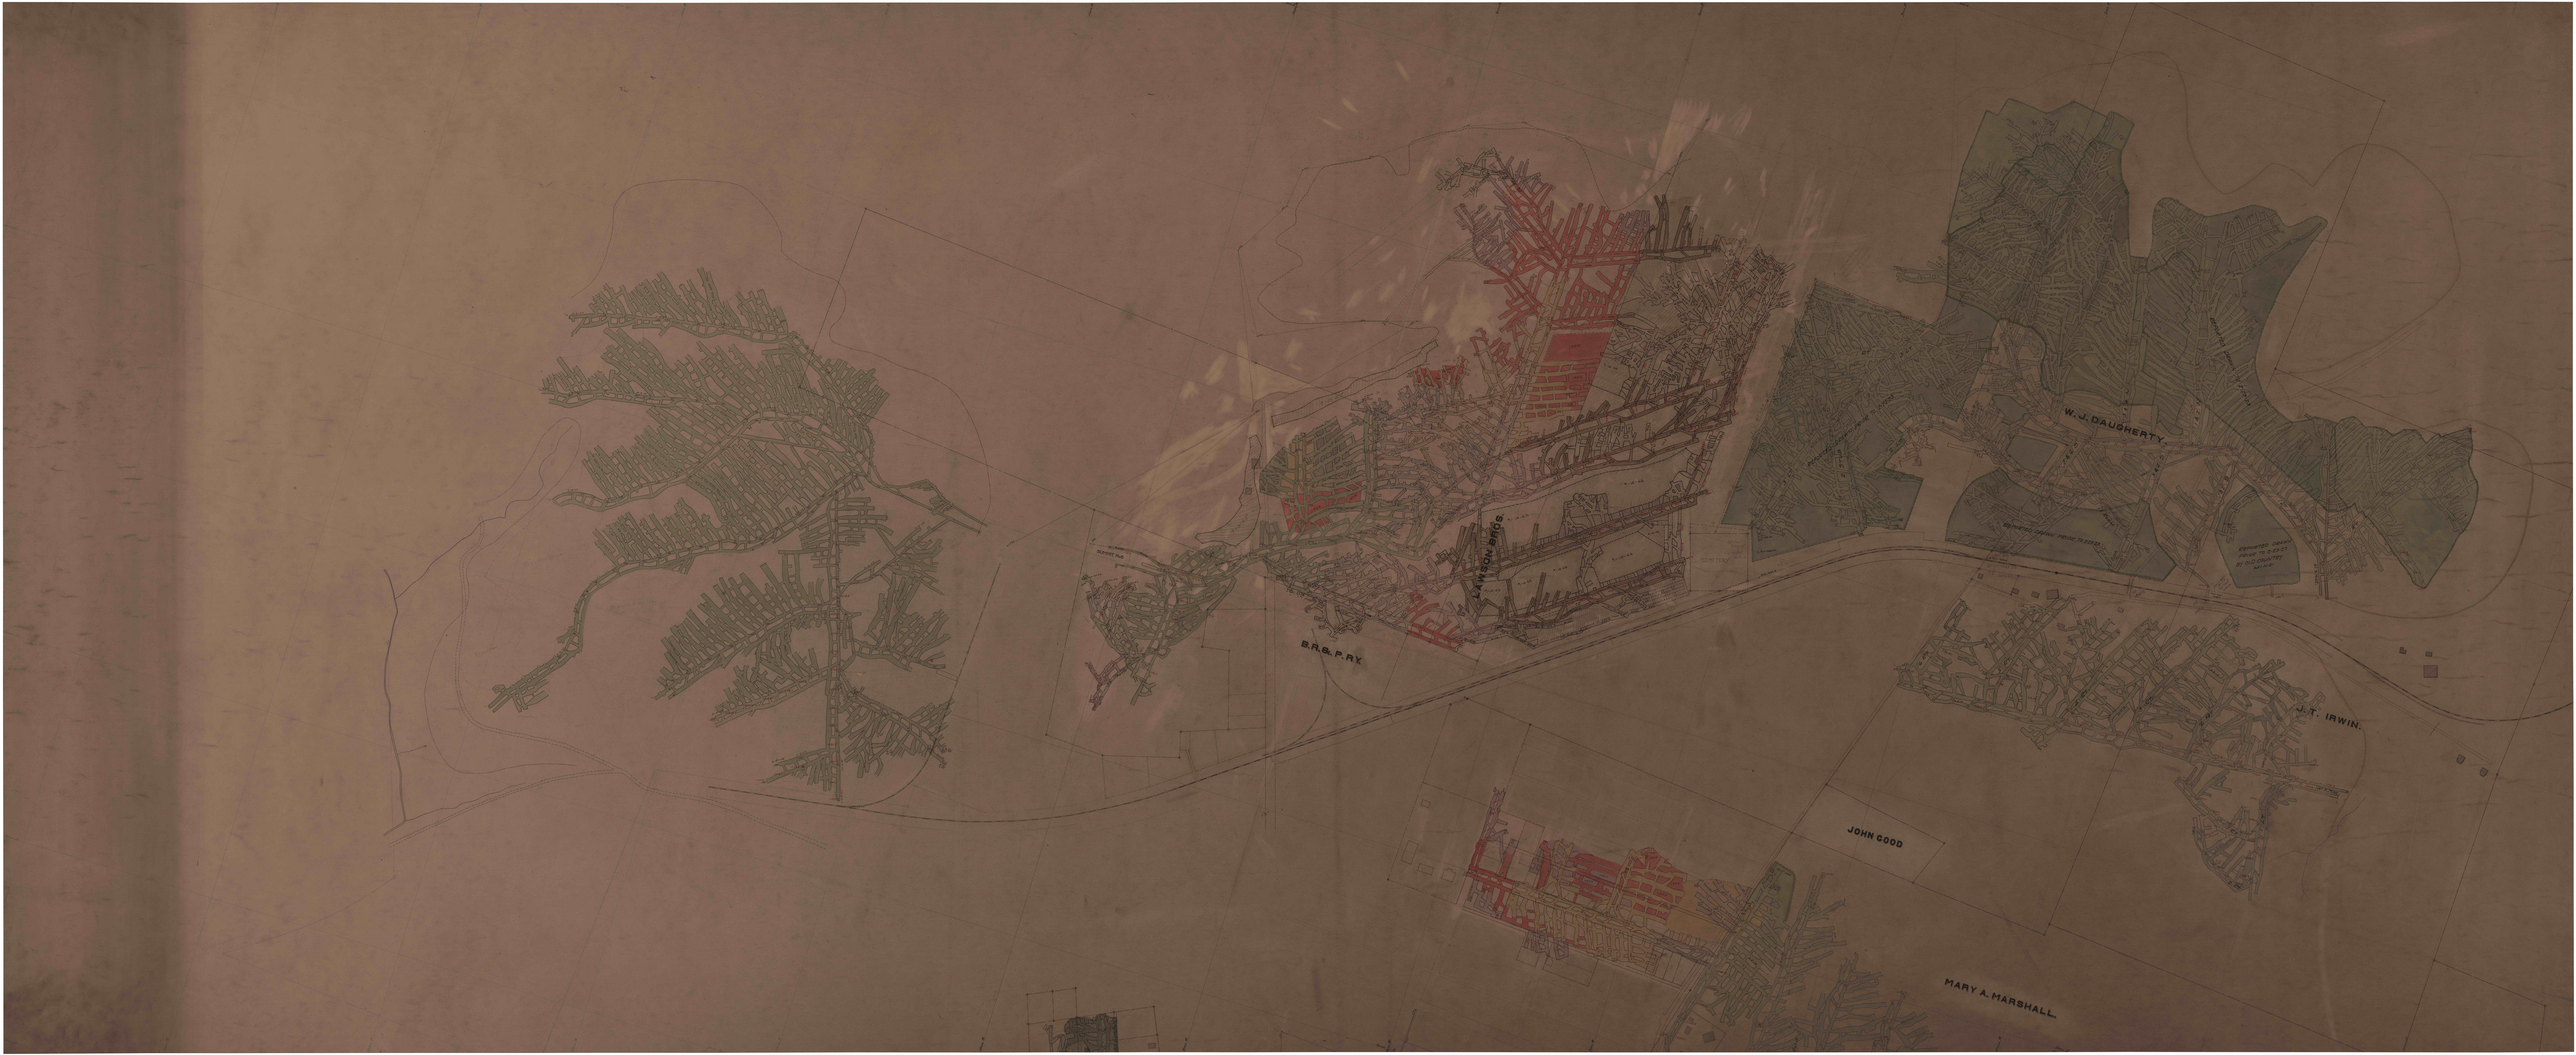
W. J. DAUGHERTY.
J. T. IRWIN.
JOHN GOOD
MARY A. MARSHALL.
B.R.&.P.RY.
J. LAWSON BROS.