MAP
OF
ROCHESTER MINE
CLEARFIELD CO. PA.

BELL, LEWIS AND YATES C.M.CO.

F. M. BROWN, ENG.

1891

1890 | 1891 | 1892 | 1893 | 1894 | 1895 | 1896 | 1897 | 1898 | 1899 | 1900 | 1901

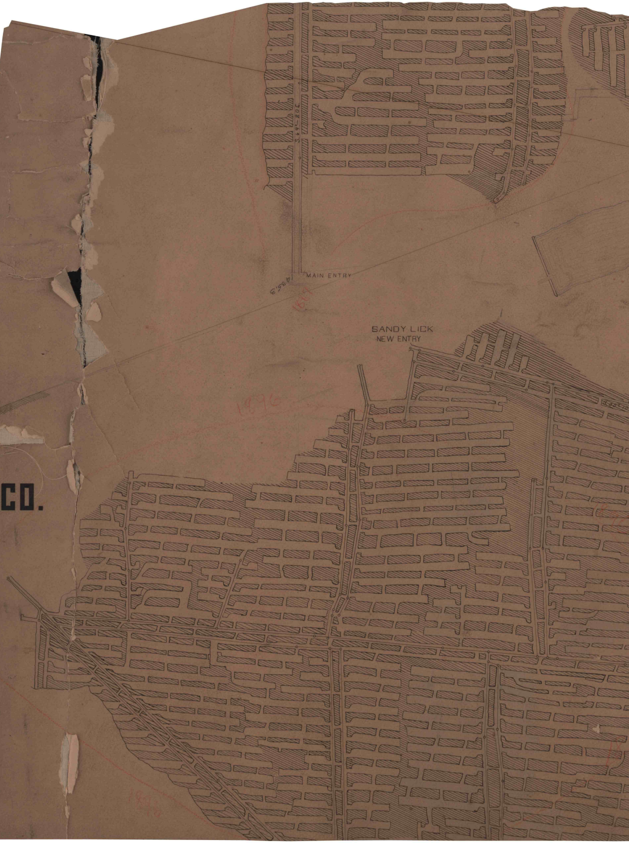
S.69°-20E
1435.3
MAIN ENTRY
1891
SANDY LICK
NEW ENTRY
1896

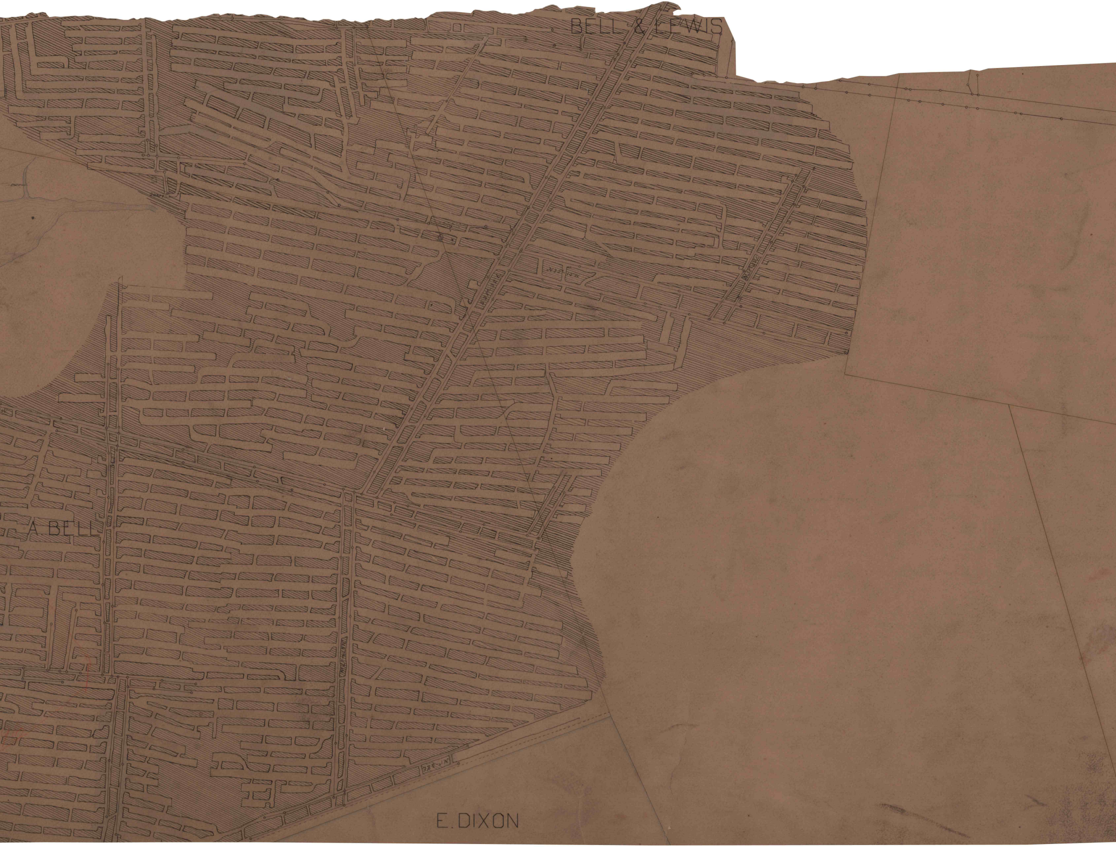
BELL & LEWIS
A. BELL
E. DIXON

CH

ARLES H PRESCOTT