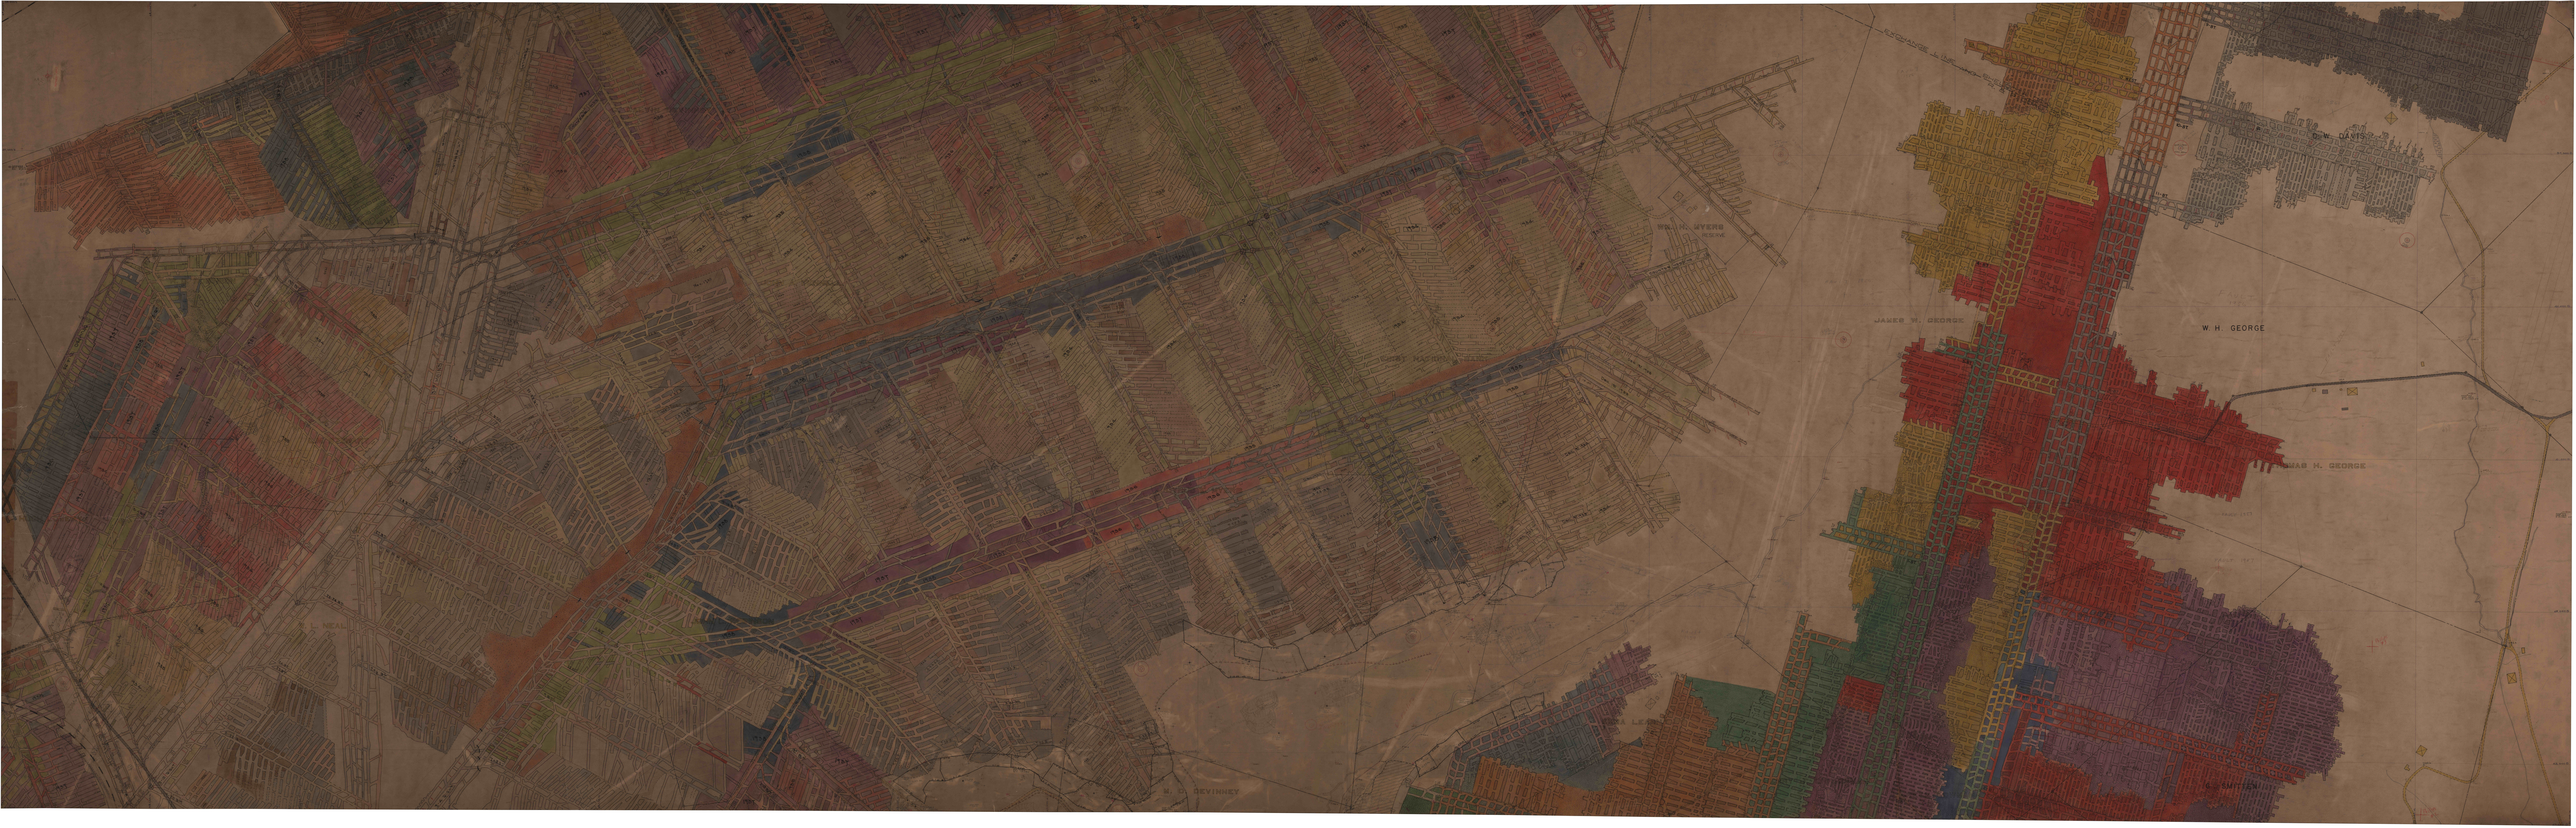
WALTER AYERS
JAMES W. GEORGE
W. H. GEORGE
THOMAS H. GEORGE
W. H. DEVINNEY
H. SMITH