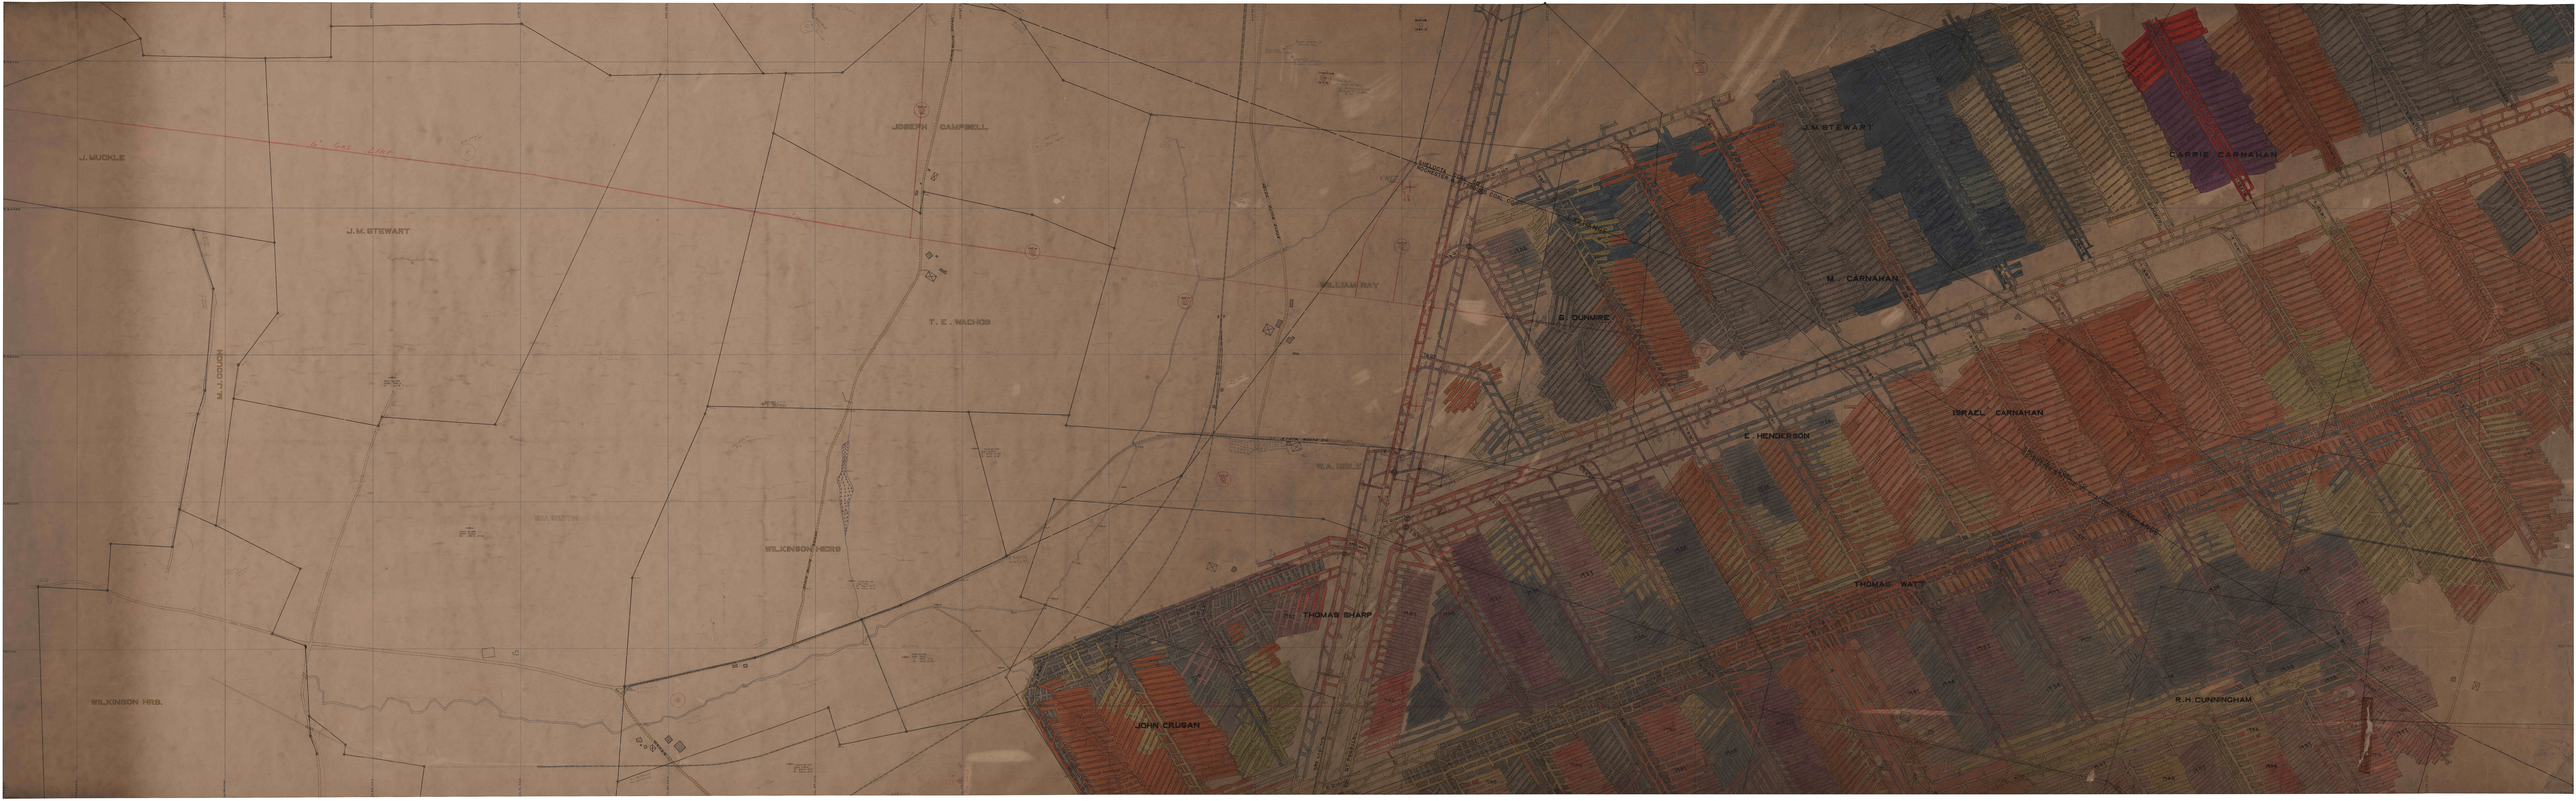
J. MUCKLE
J. M. STEWART
M. J. COUCH
JOSEPH CAMPBELL
T. E. WACHOB
WILLIAM RAY
WILKINSON HRS.
WILKINSON HRS
W. SMITH
W.A. DELL
J.M. STEWART
CARRIE CARNAHAN
M. CARNAHAN
B. DUNMIRE
E. HENDERSON
ISRAEL CARNAHAN
THOMAS WATT
THOMAS SHARP
JOHN CRUGAN
R.H. CUNNINGHAM