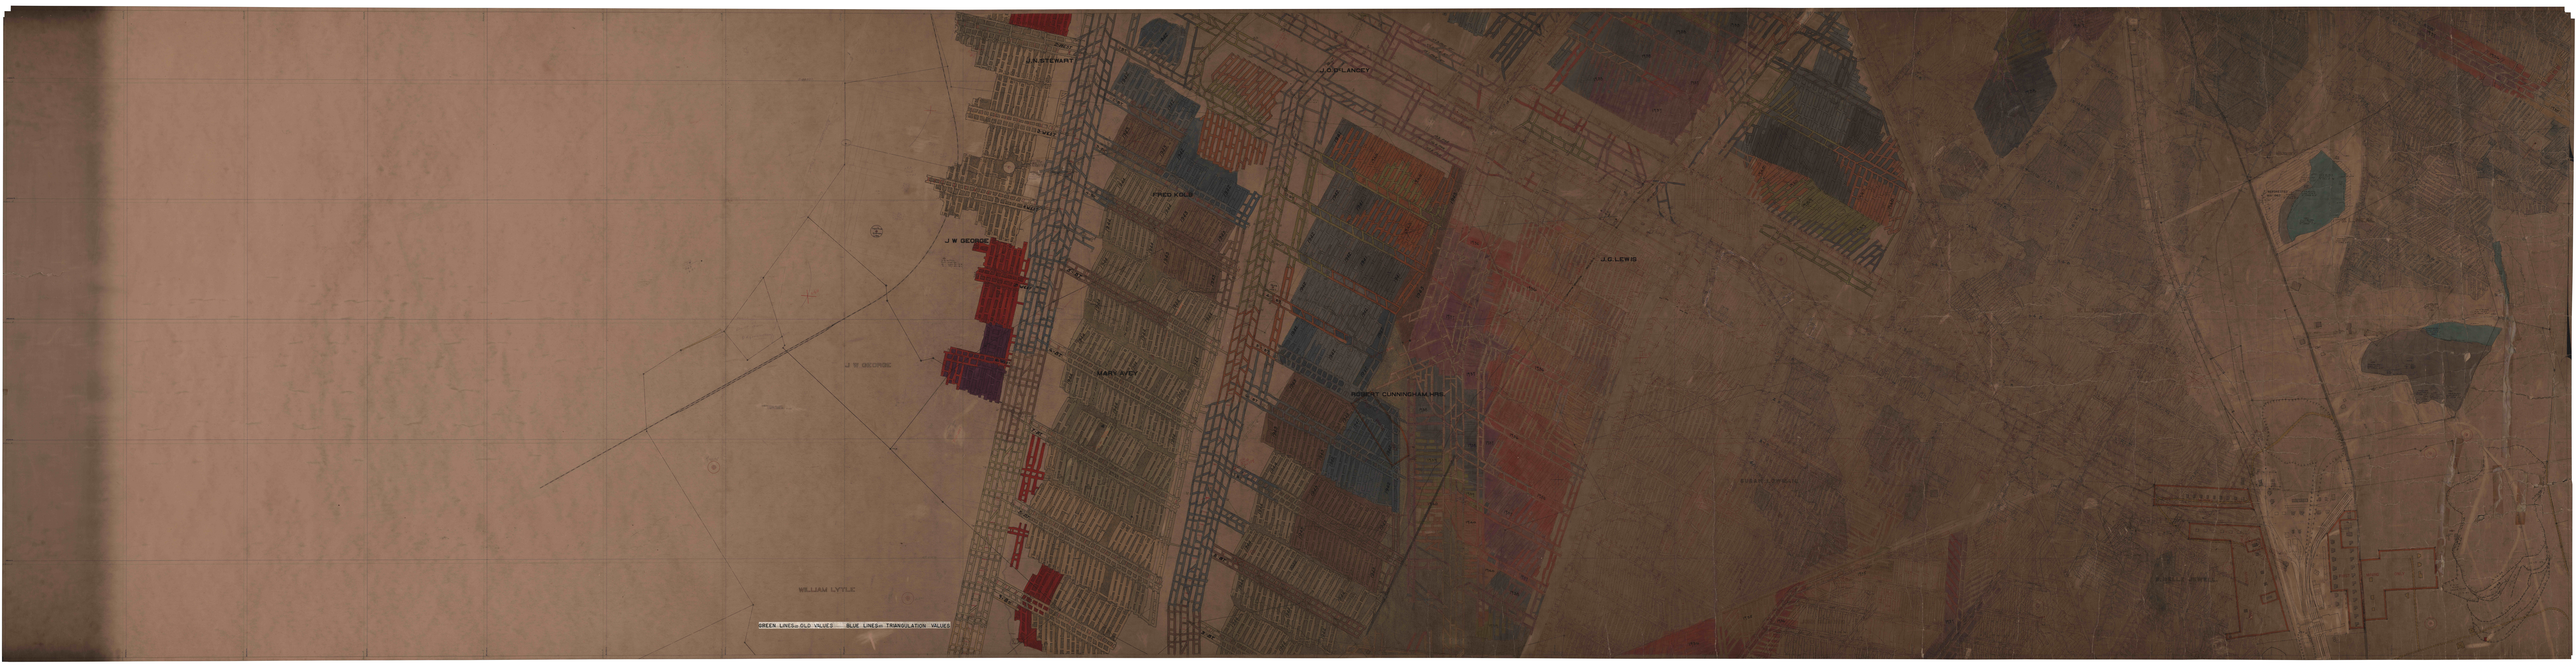
J.N.STEWART
J.O.D.LANGEY
FRED KOLB
J W GEORGE
J.C.LEWIS
MARY A.FEY
ROBERT CUNNINGHAM,HRS.
WILLIAM LYTLE
GREEN LINES= OLD VALUES BLUE LINES= TRANSOLATION VALUES