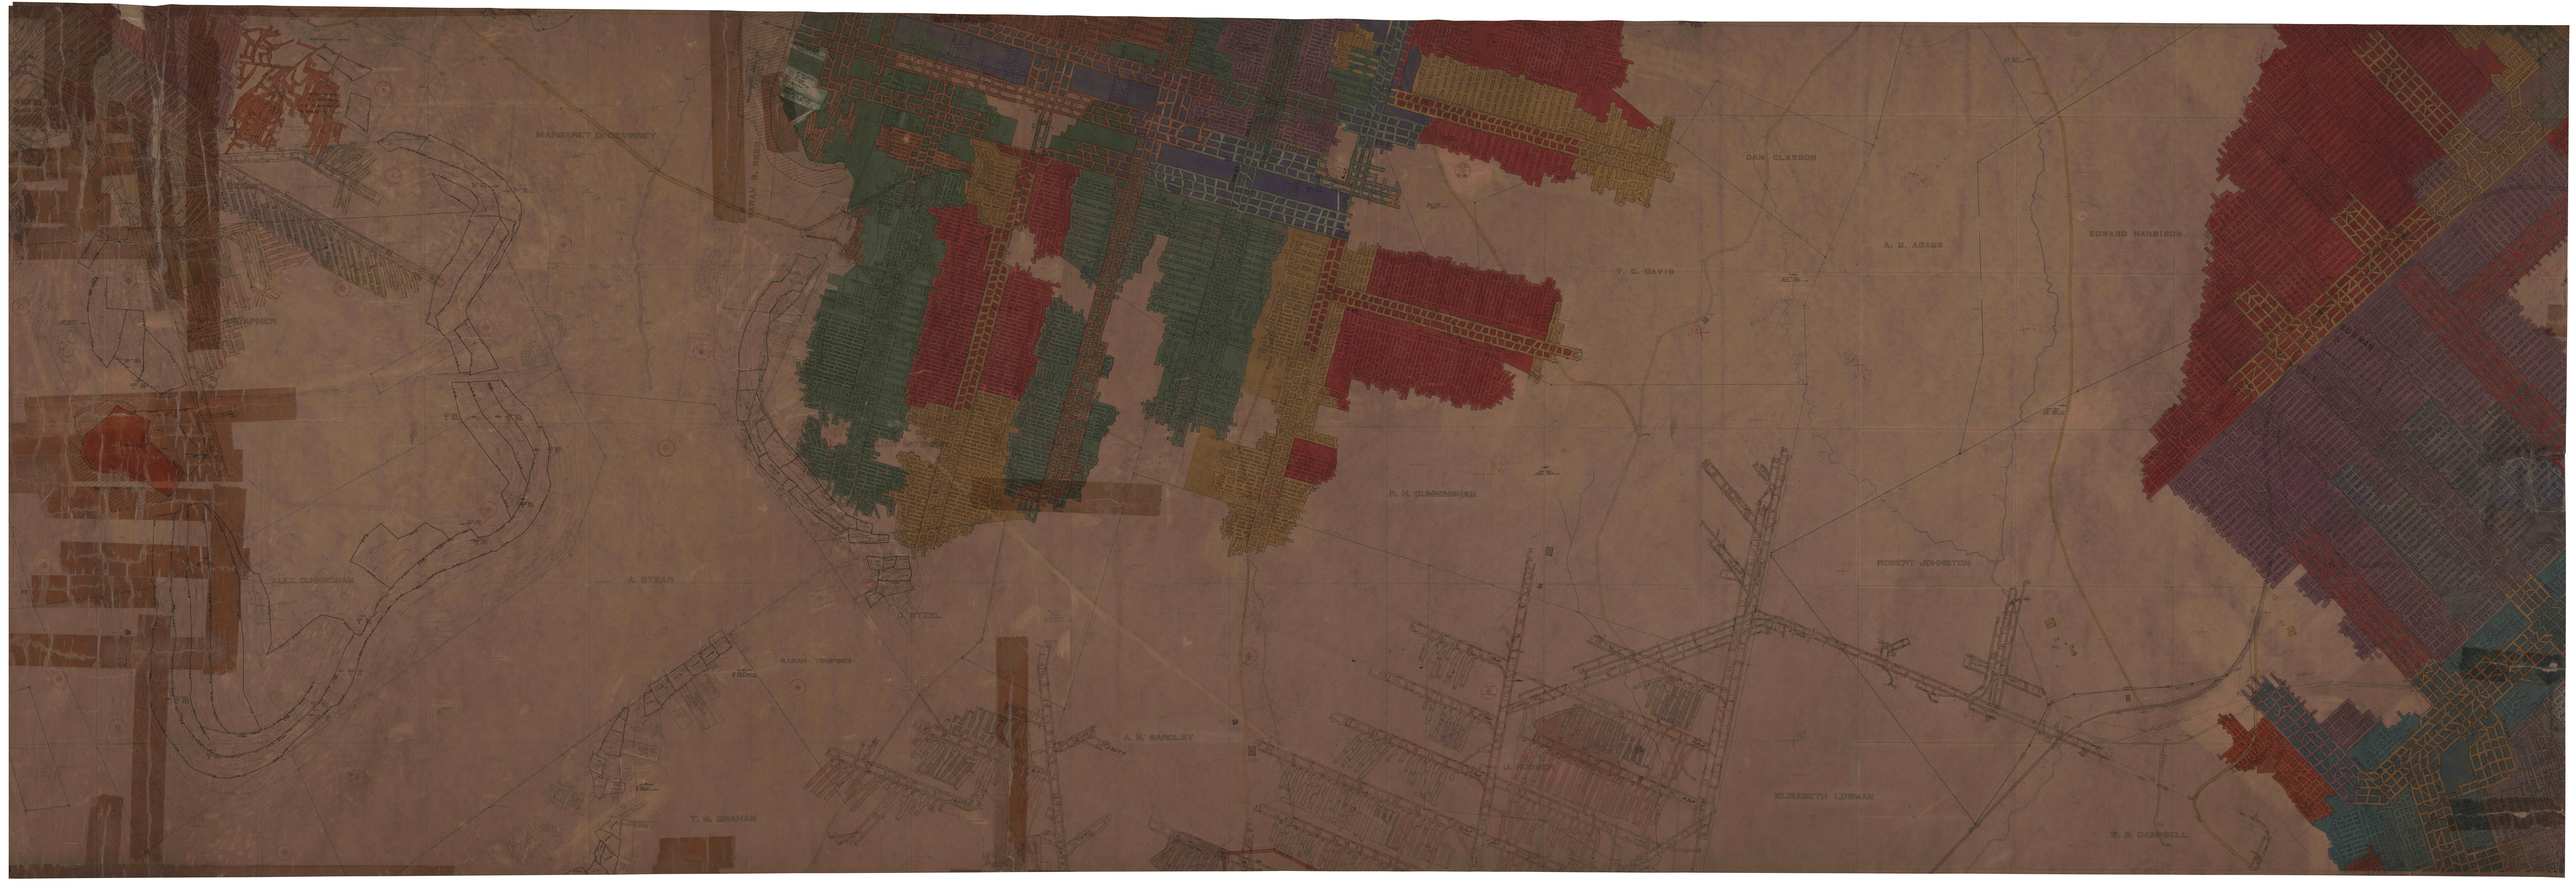
MARGARET DEVINNEY
DAN CLAYSON
A. W. ADAMS
EDWARD HARRISON
T. C. DAVIS
R. H. CUNNINGHAM
ROBERT JOHNSTON
ALEX. CUNNINGHAM
A. STEAR
SARAH THOMPSON
A. M. BARCLAY
ELIZABETH LOWMAN
T. M. GRAHAM
W. B. CAMPBELL