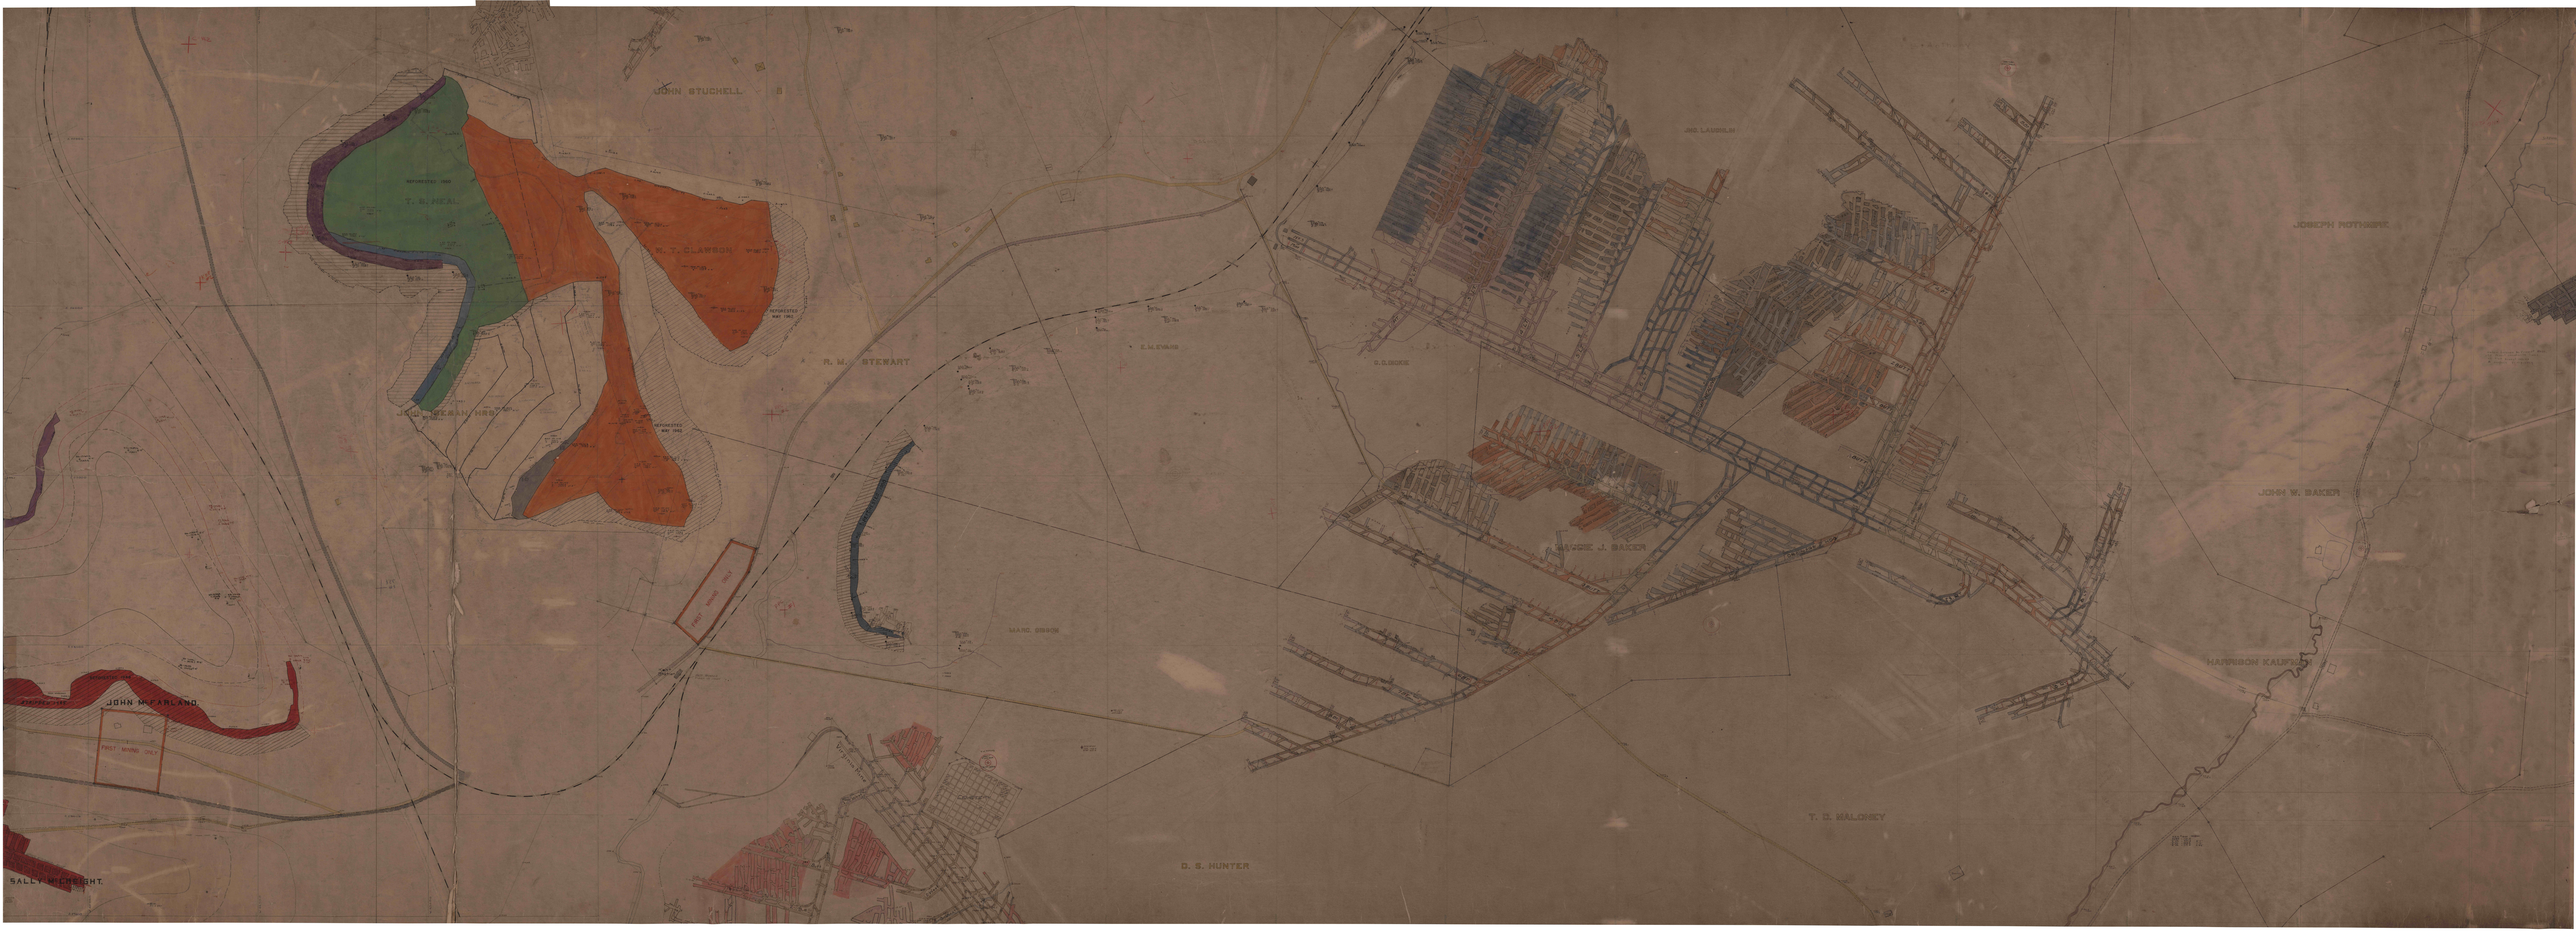
JOHN STUCHELL
REFORESTED 1908
T. B. NEAL
W. T. CLAWSON
REFORESTED MAY 1905
REFORESTED MAY 1905
R. M. STEWART
E.M.EVANS
G.O.SUKE
JAS. LAUGHLIN
JOSEPH MOTHERS
JOHN W. BAKER
WAYNE J. BAKER
MARC. SIMON
HARRISON KAUFFMAN
FIRST MINING ONLY
JOHN McFARLAND
FIRST MINING ONLY
SALLY McDONIGHT.
T. D. MALONEY
D. S. HUNTER