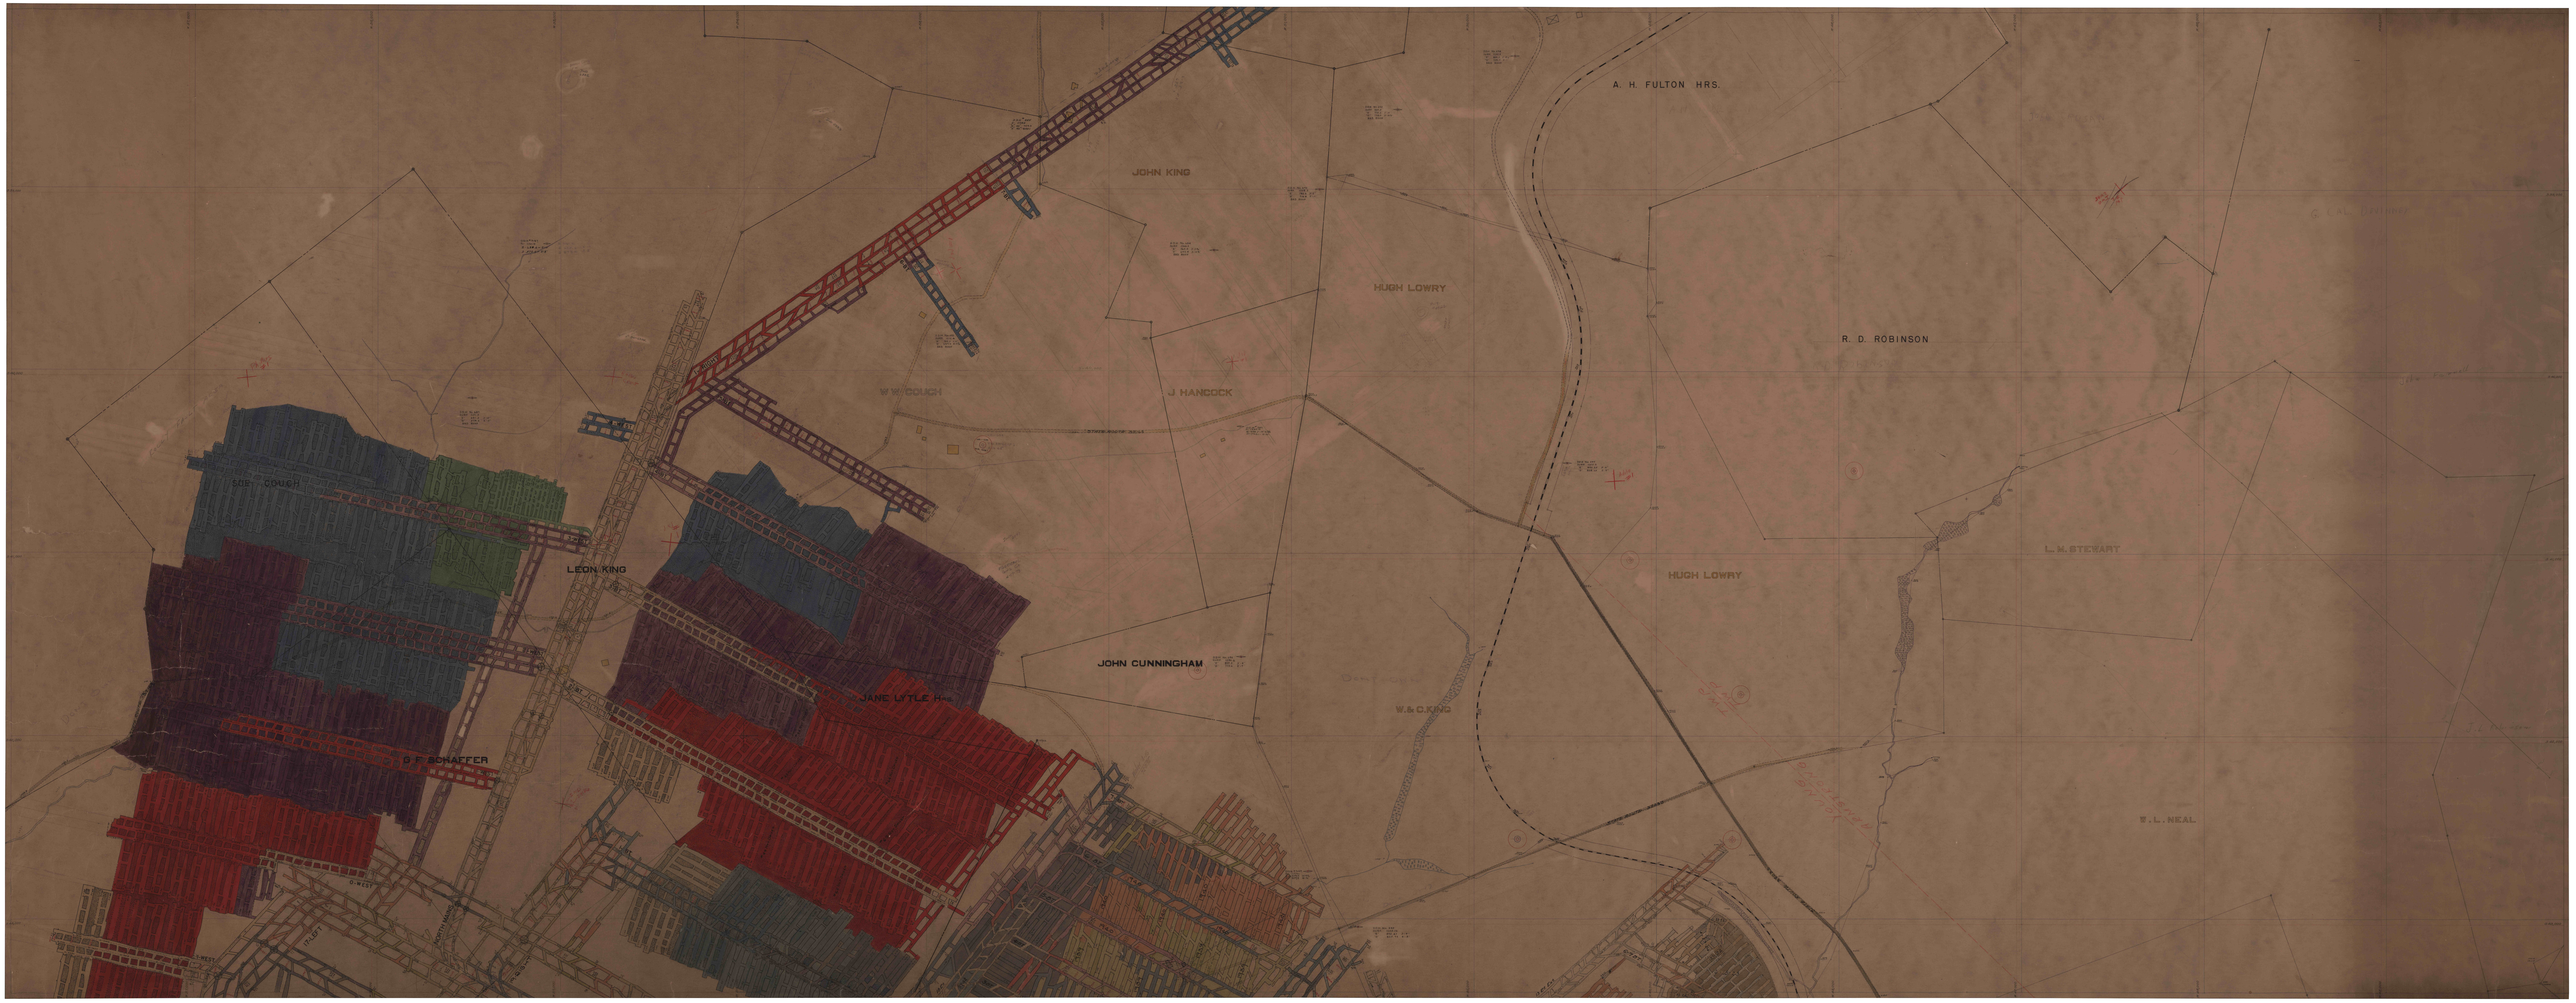
A. H. FULTON HRS.
JOHN KING
HUGH LOWRY
R. D. ROBINSON
W. W. COUCH
J. HANCOCK
SUSY COUCH
LEON KING
L. M. STEWART
HUGH LOWRY
JOHN CUNNINGHAM
JANE LITTLE HRS.
W. & C. KING
G. F. SCHAFFER
W. L. NEAL