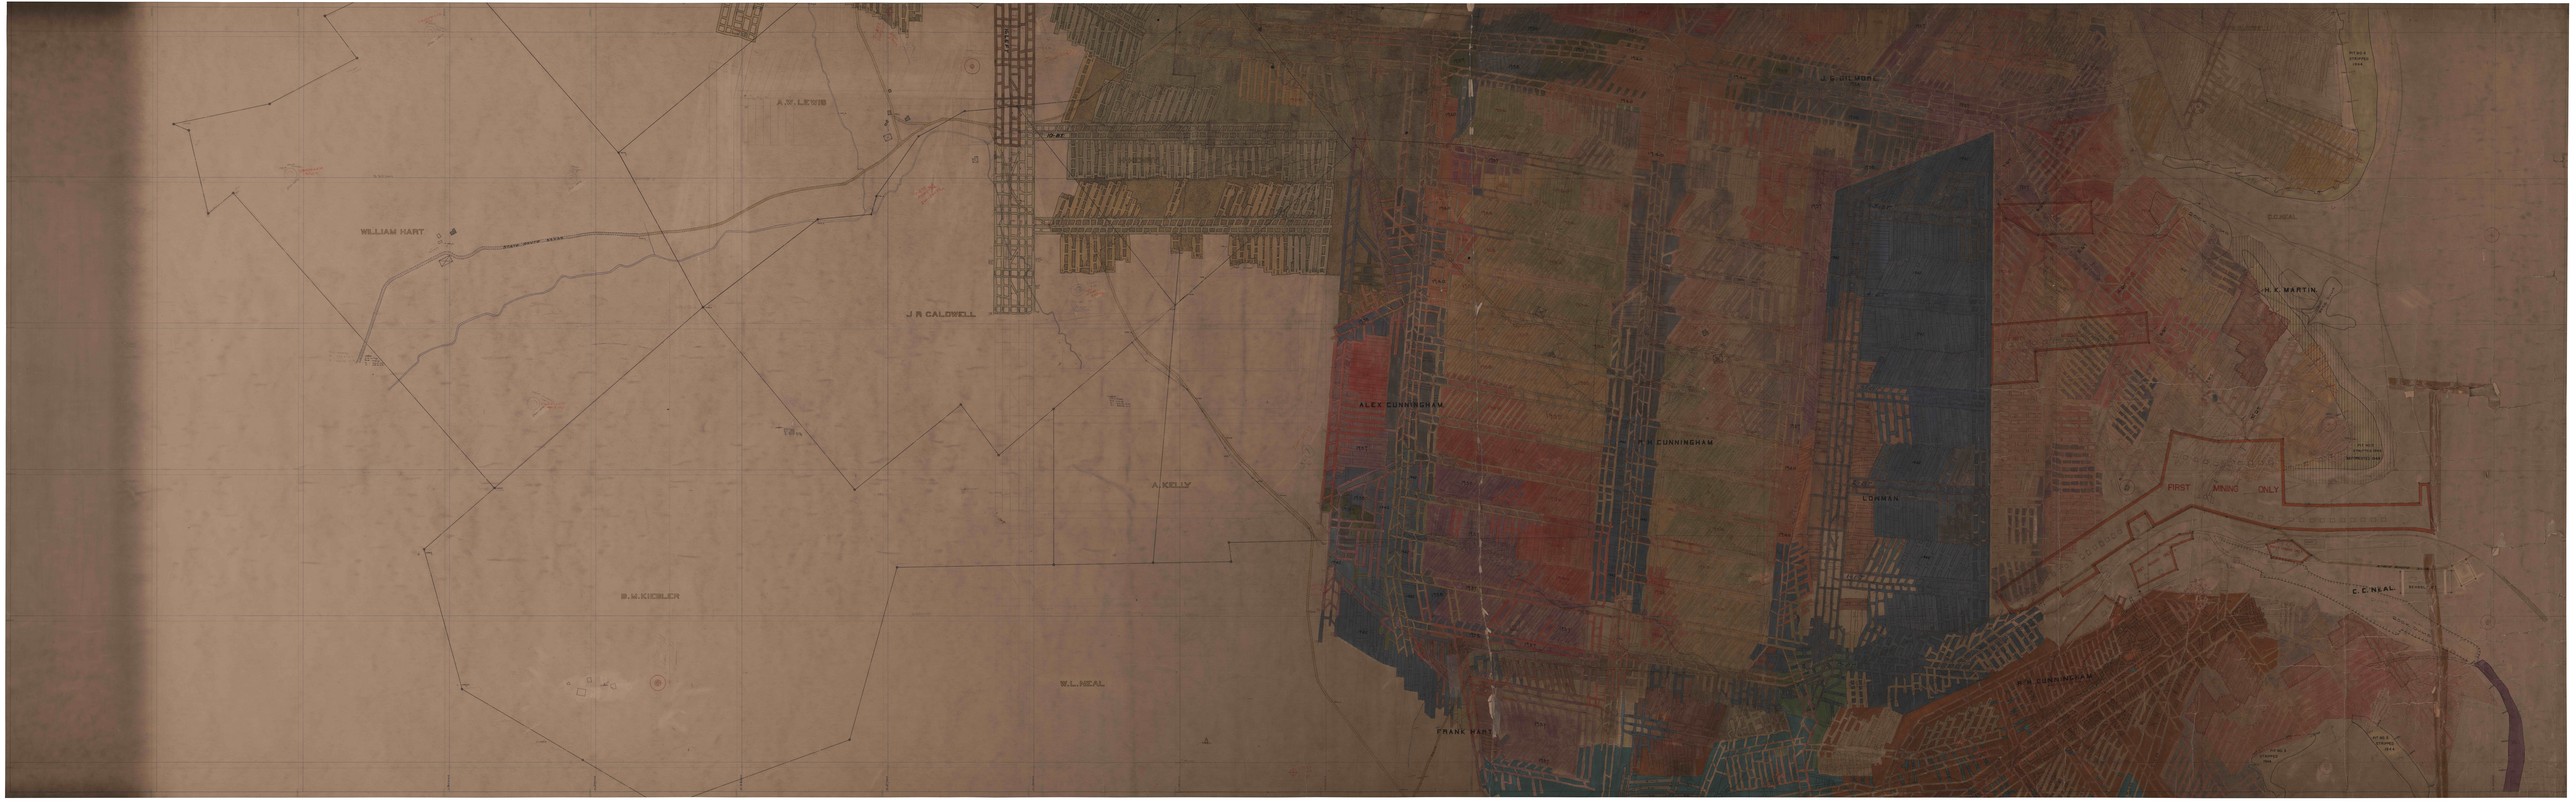
A.W. LEWIS
WILLIAM HART
J R CALDWELL
A. KELLY
B.W. KIEBLER
W.L. NEAL
ALEX CUNNINGHAM
T.H. CUNNINGHAM
LOHMAN
FRANK HART
J.B. GILMORE
H.K. MARTIN
FIRST MINING ONLY
C.E. NEAL
H.N. CUNNINGHAM