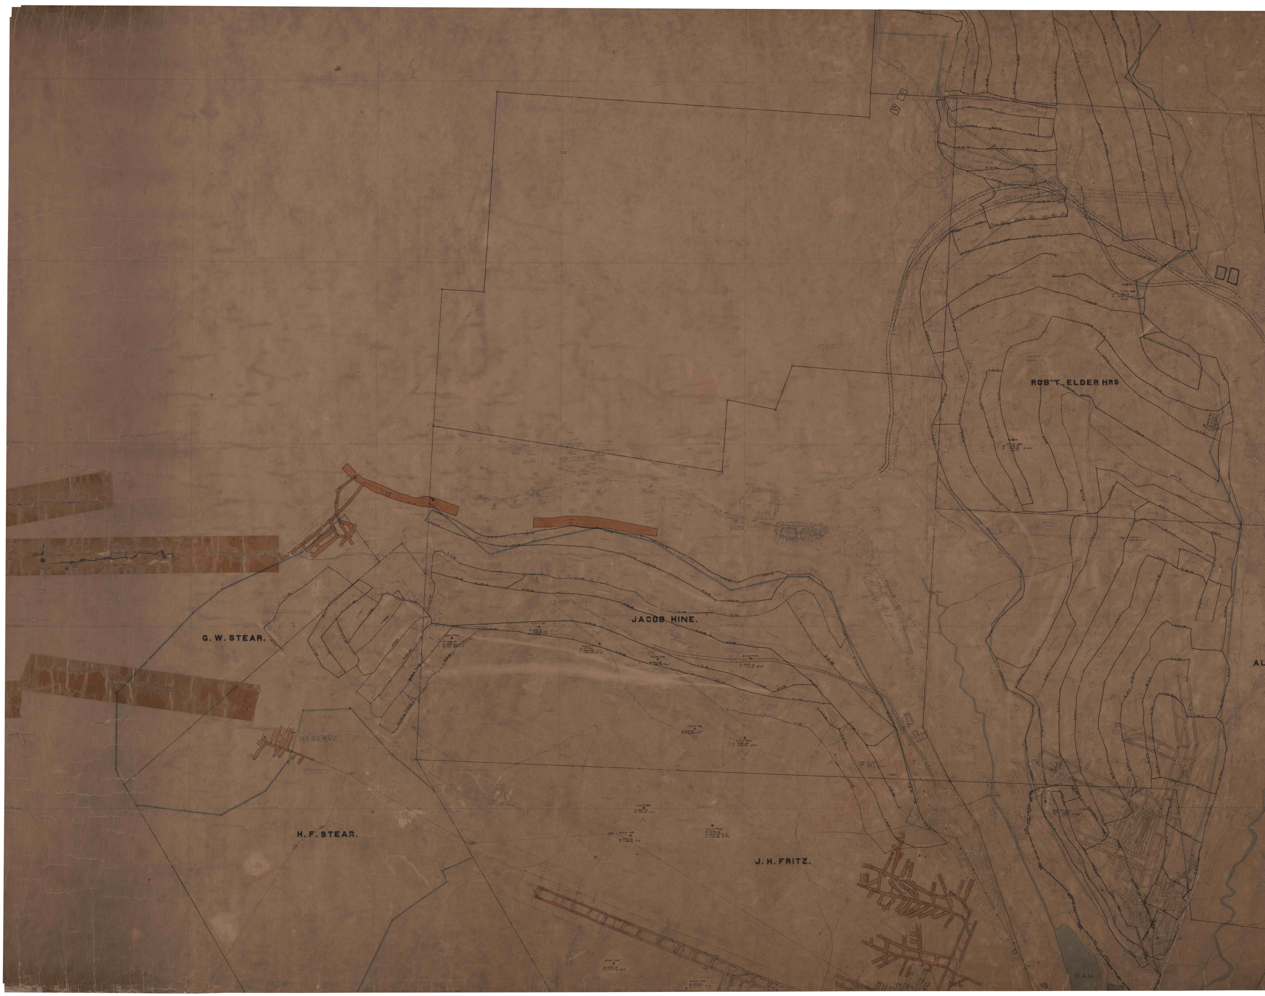
ROB'T. ELDER HRS
JACOB HINE.
G. W. STEAR.
RESERVE
H. F. STEAR.
J. H. FRITZ.
AL
DAM

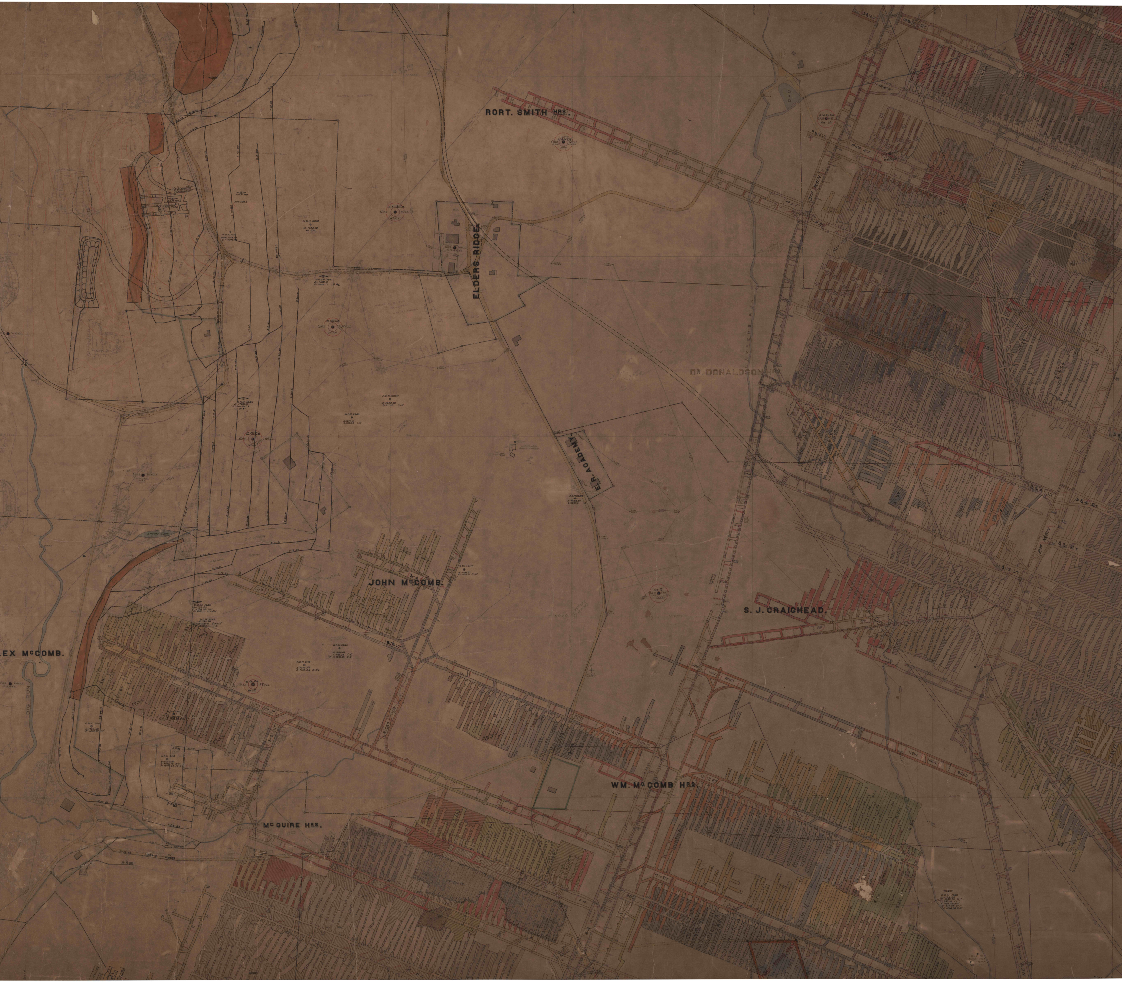
RORT. SMITH HRS.
ELDERS RIDGE
E.R. ACADEMY
DR. DONALDSON HRS
HARPERS R
JOHN McCOMB.
S. J. CRAIGHEAD.
LEX McCOMB.
BIG RUN
WM. McCOMB HRS.
McGUIRE HRS.

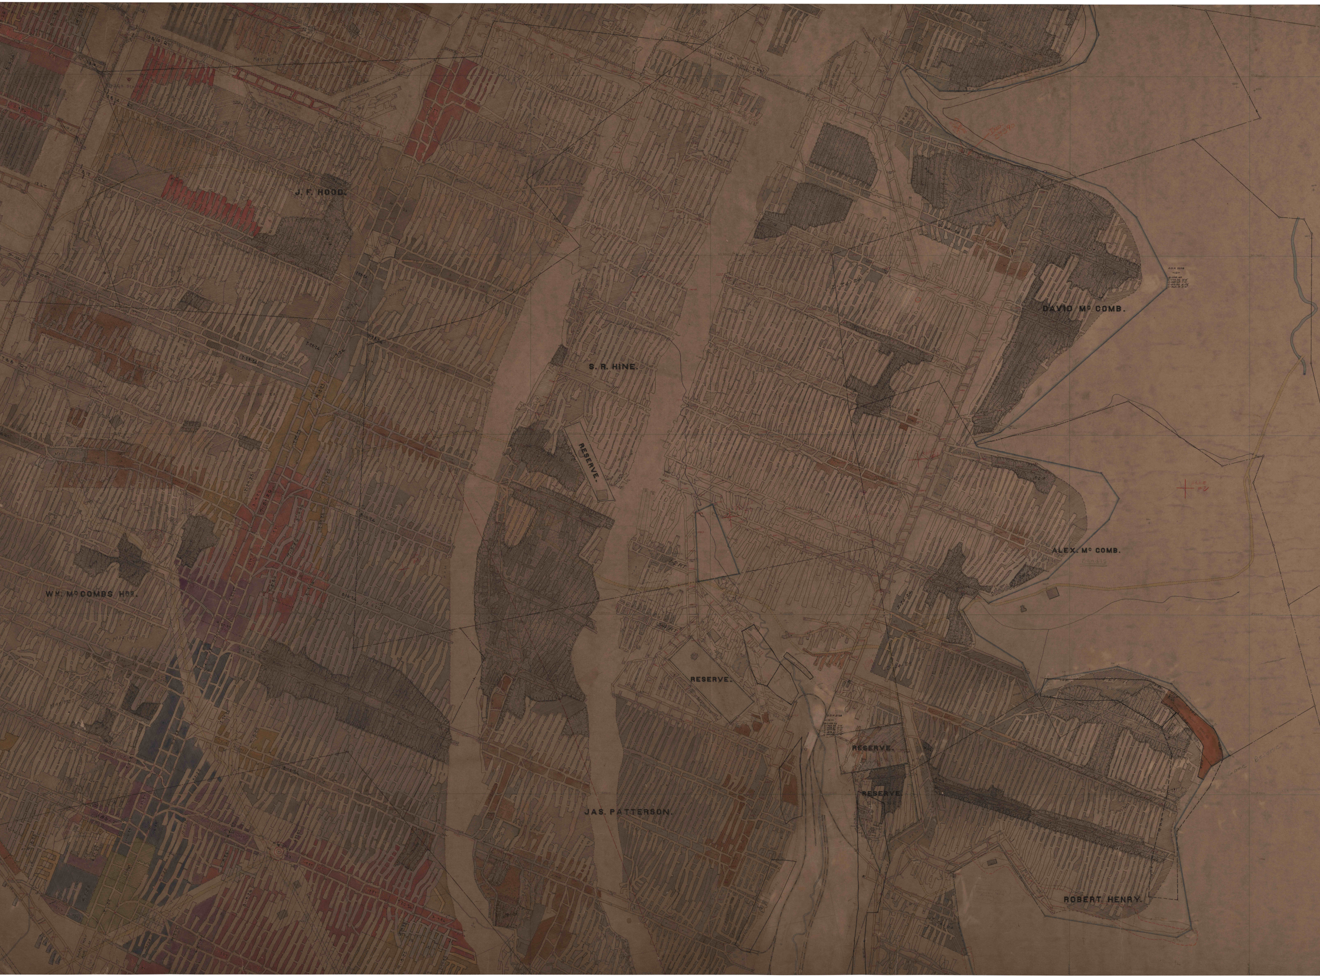
J. F. HOOD.
DAVID Mc COMB.
S. R. HINE.
RESERVE.
ALEX. Mc COMB.
Wm. Mc COMBS Hrs.
RESERVE.
RESERVE.
RESERVE.
JAS. PATTERSON.
ROBERT. HENRY.

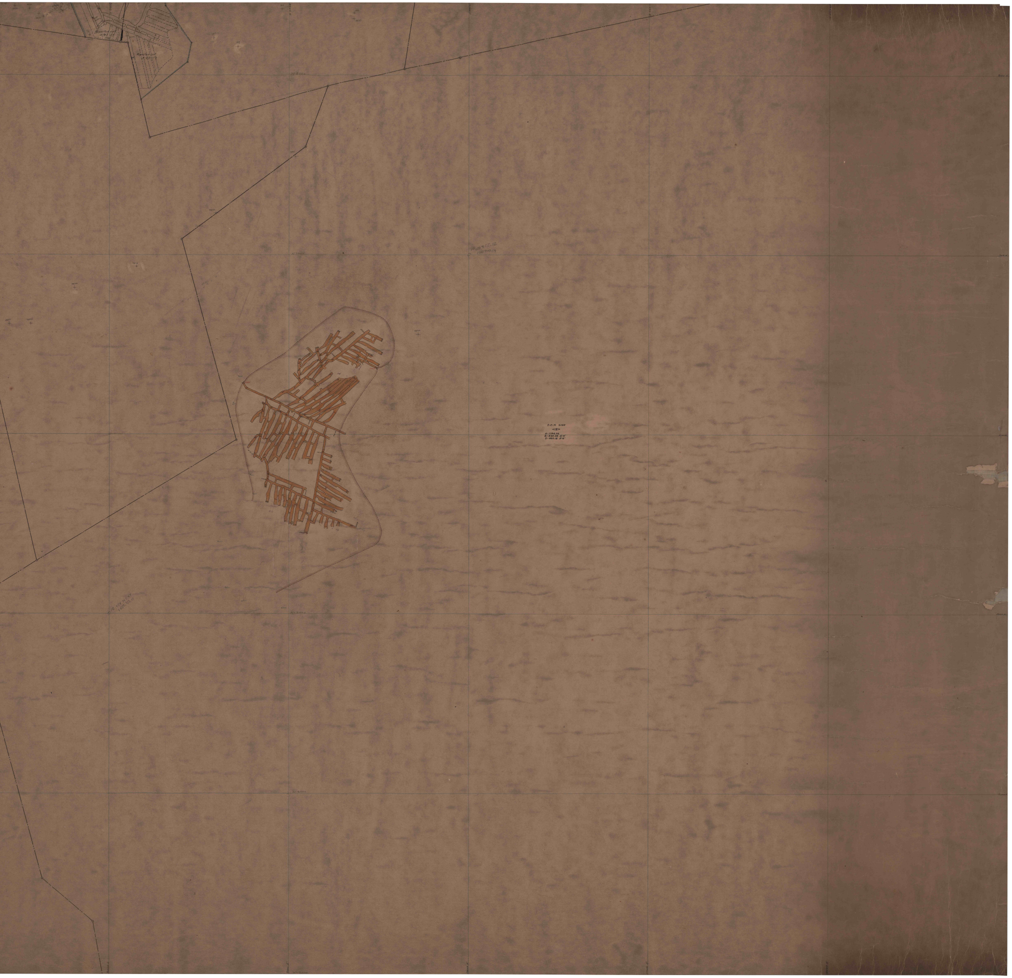
Reported out
4-27-42
Reported out
4-22-42
D.D.H. 2122
E-1194.95
X-524.28 3'-6"
D-460.12 3'-6"