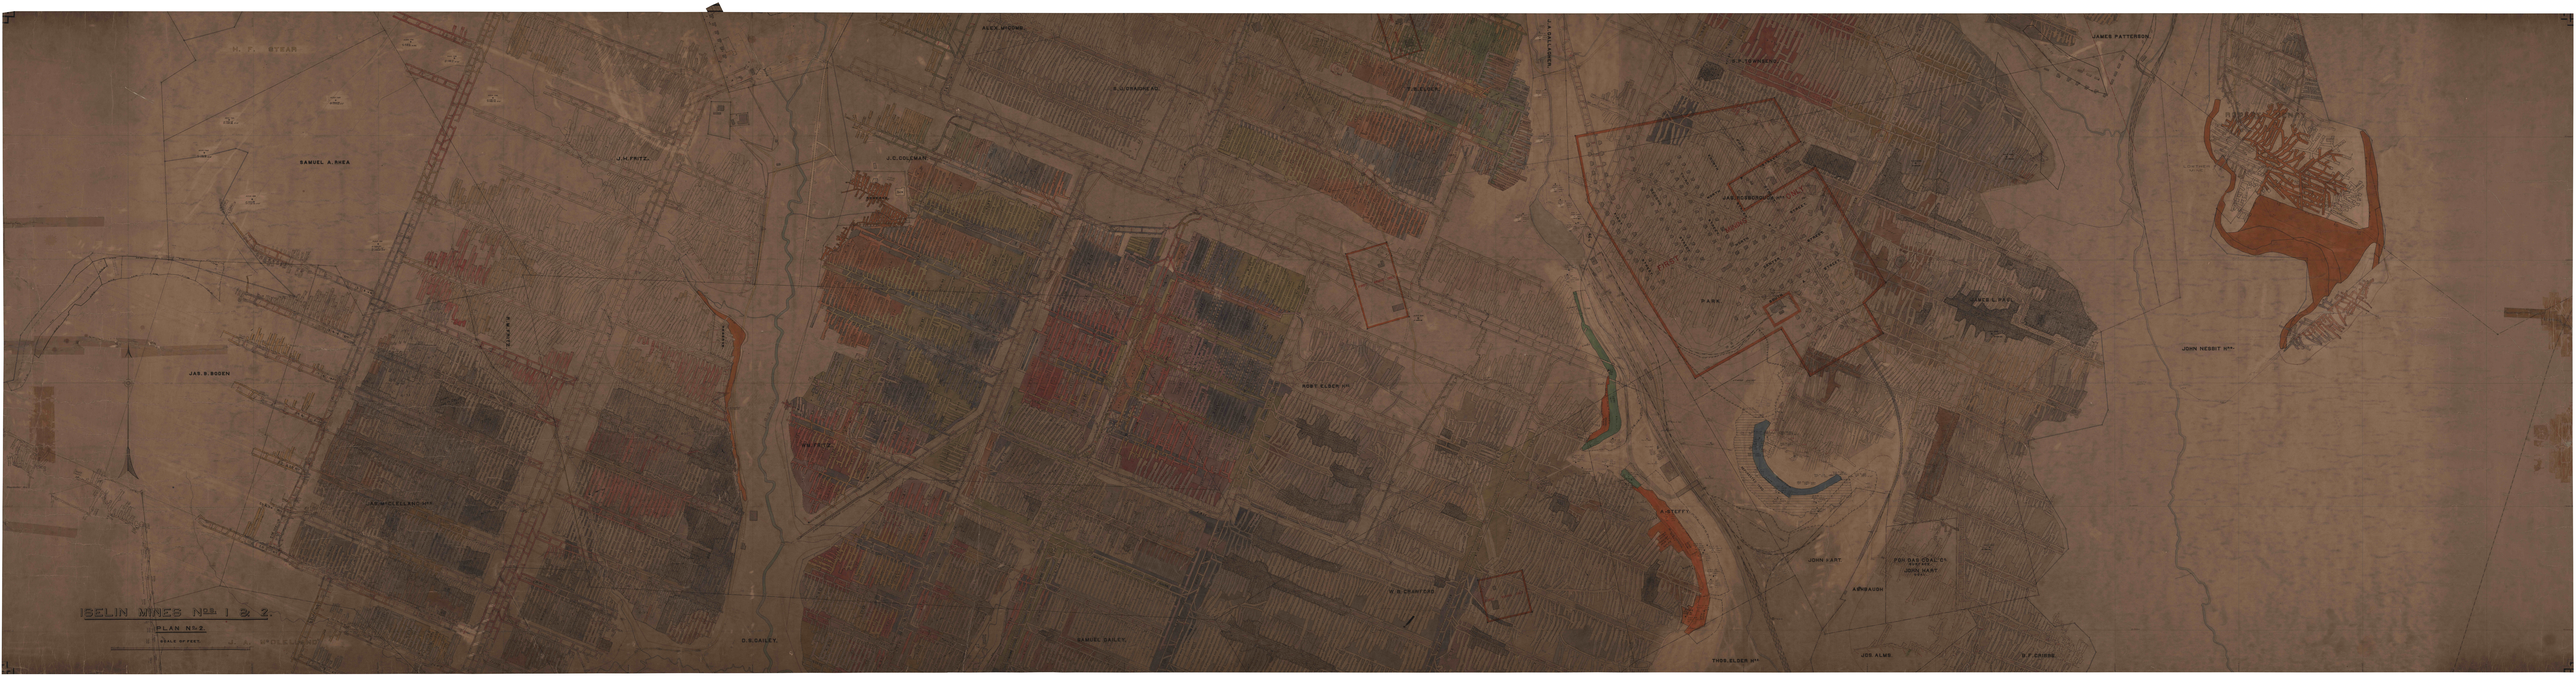
ISELIN MINES Nos. 1 & 2.
PLAN No. 2.
SCALE 50 FEET.
J. A. McCLELLAND
H. F. BYEAR
SAMUEL A. RHEA
J. H. FRITZ
J. C. COLEMAN
ALEX. MCCOMB
S. J. GRAHAM
J. R. ELDER
J. A. DALLAGHER
S. P. TOWNSEND
JAMES PATTERSON
JAS. B. BODEN
JAS. McCLELLAND Nos.
ROBT. ELDER Nos.
PARK
JAMES L. PAY
JOHN NESBIT Nos.
A. STEFFY
JOHN HART
FOR GAS COAL CO.
JOHN HART
ASHBAUGH
W. B. CRAWFORD
D. S. CAILEY
SAMUEL DAILEY
THOS. ELDER Nos.
JOS. ALMS
W. F. CRIBBS