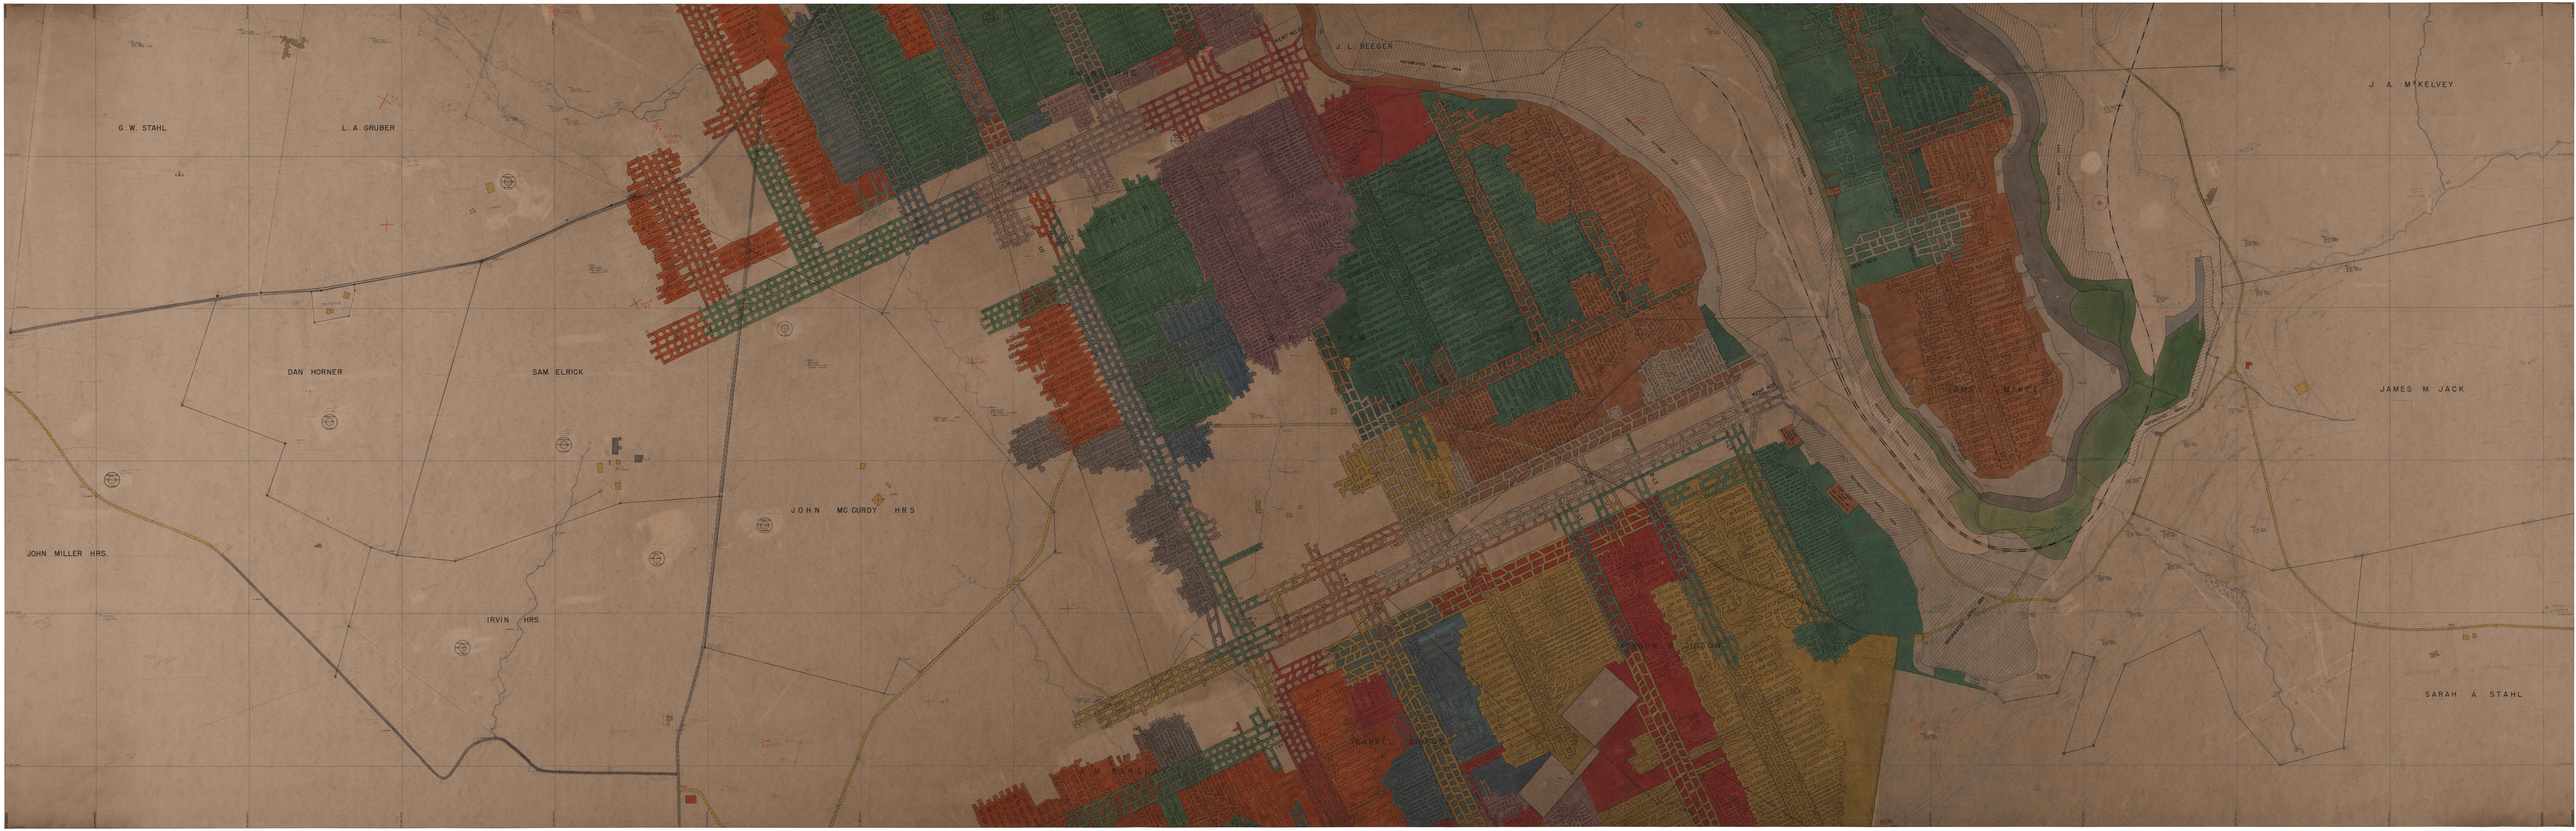
G. W. STAHL
L. A. GRUBER
DAN HORNER
SAM ELRICK
JOHN MILLER HRS.
IRVIN HRS.
JOHN MC CURDY HRS
J. L. REEGER
J. A. MCKELVEY
JAMES M JACK
SARAH A STAHL