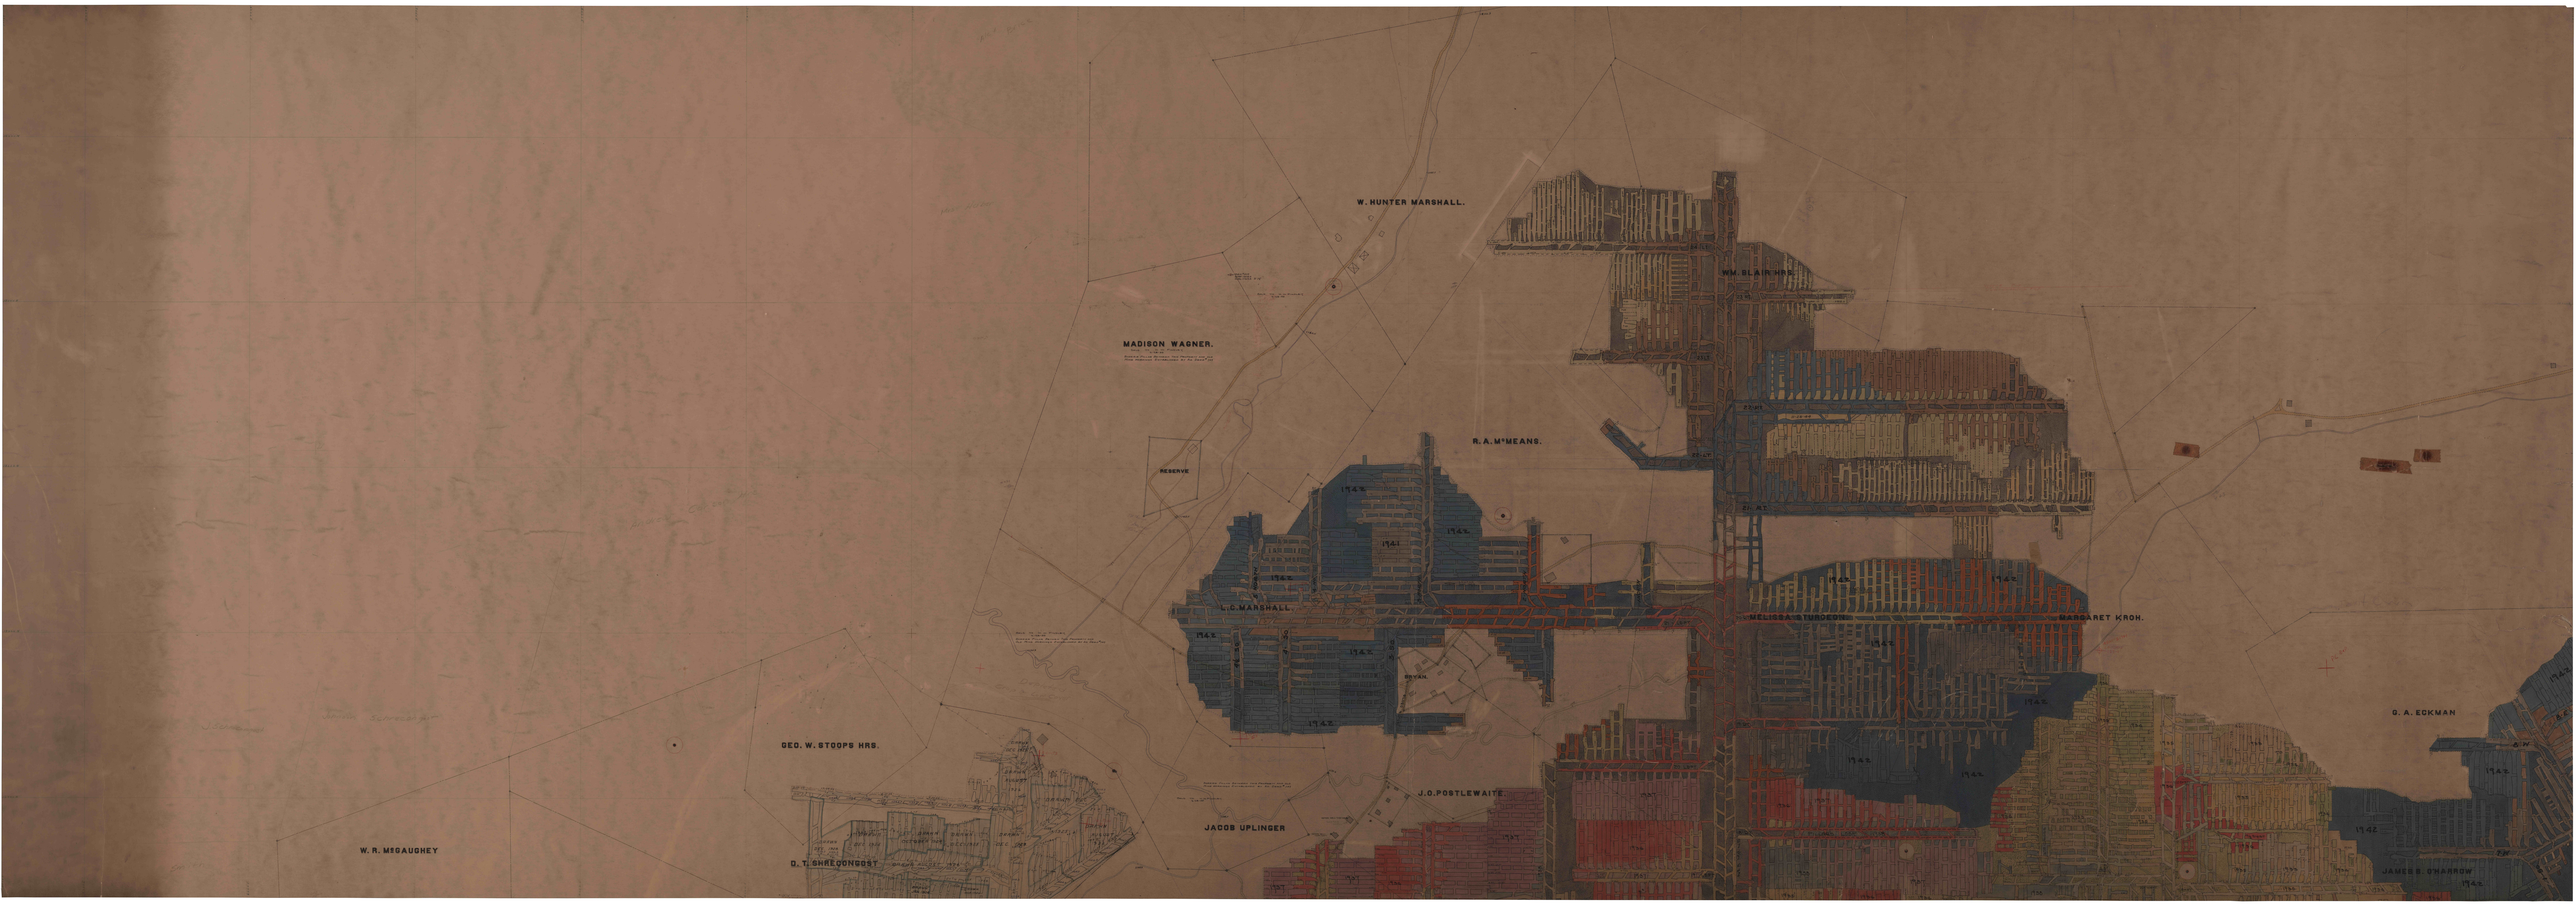
W. HUNTER MARSHALL.
WM. BLAIR HRS.
MADISON WAGNER.
R. A. McMEANS.
RESERVE
L. C. MARSHALL.
MELISSA TURDEUS
MARGARET KROH.
BRYAN.
G. A. ECKMAN
GEO. W. STOOPS HRS.
J. O. POSTLEWAITE.
JACOB UPLINGER
W. R. McGAUGHEY
D. T. SHREQONGOST
JAMES B. O'HARROW
1942
1941
1937