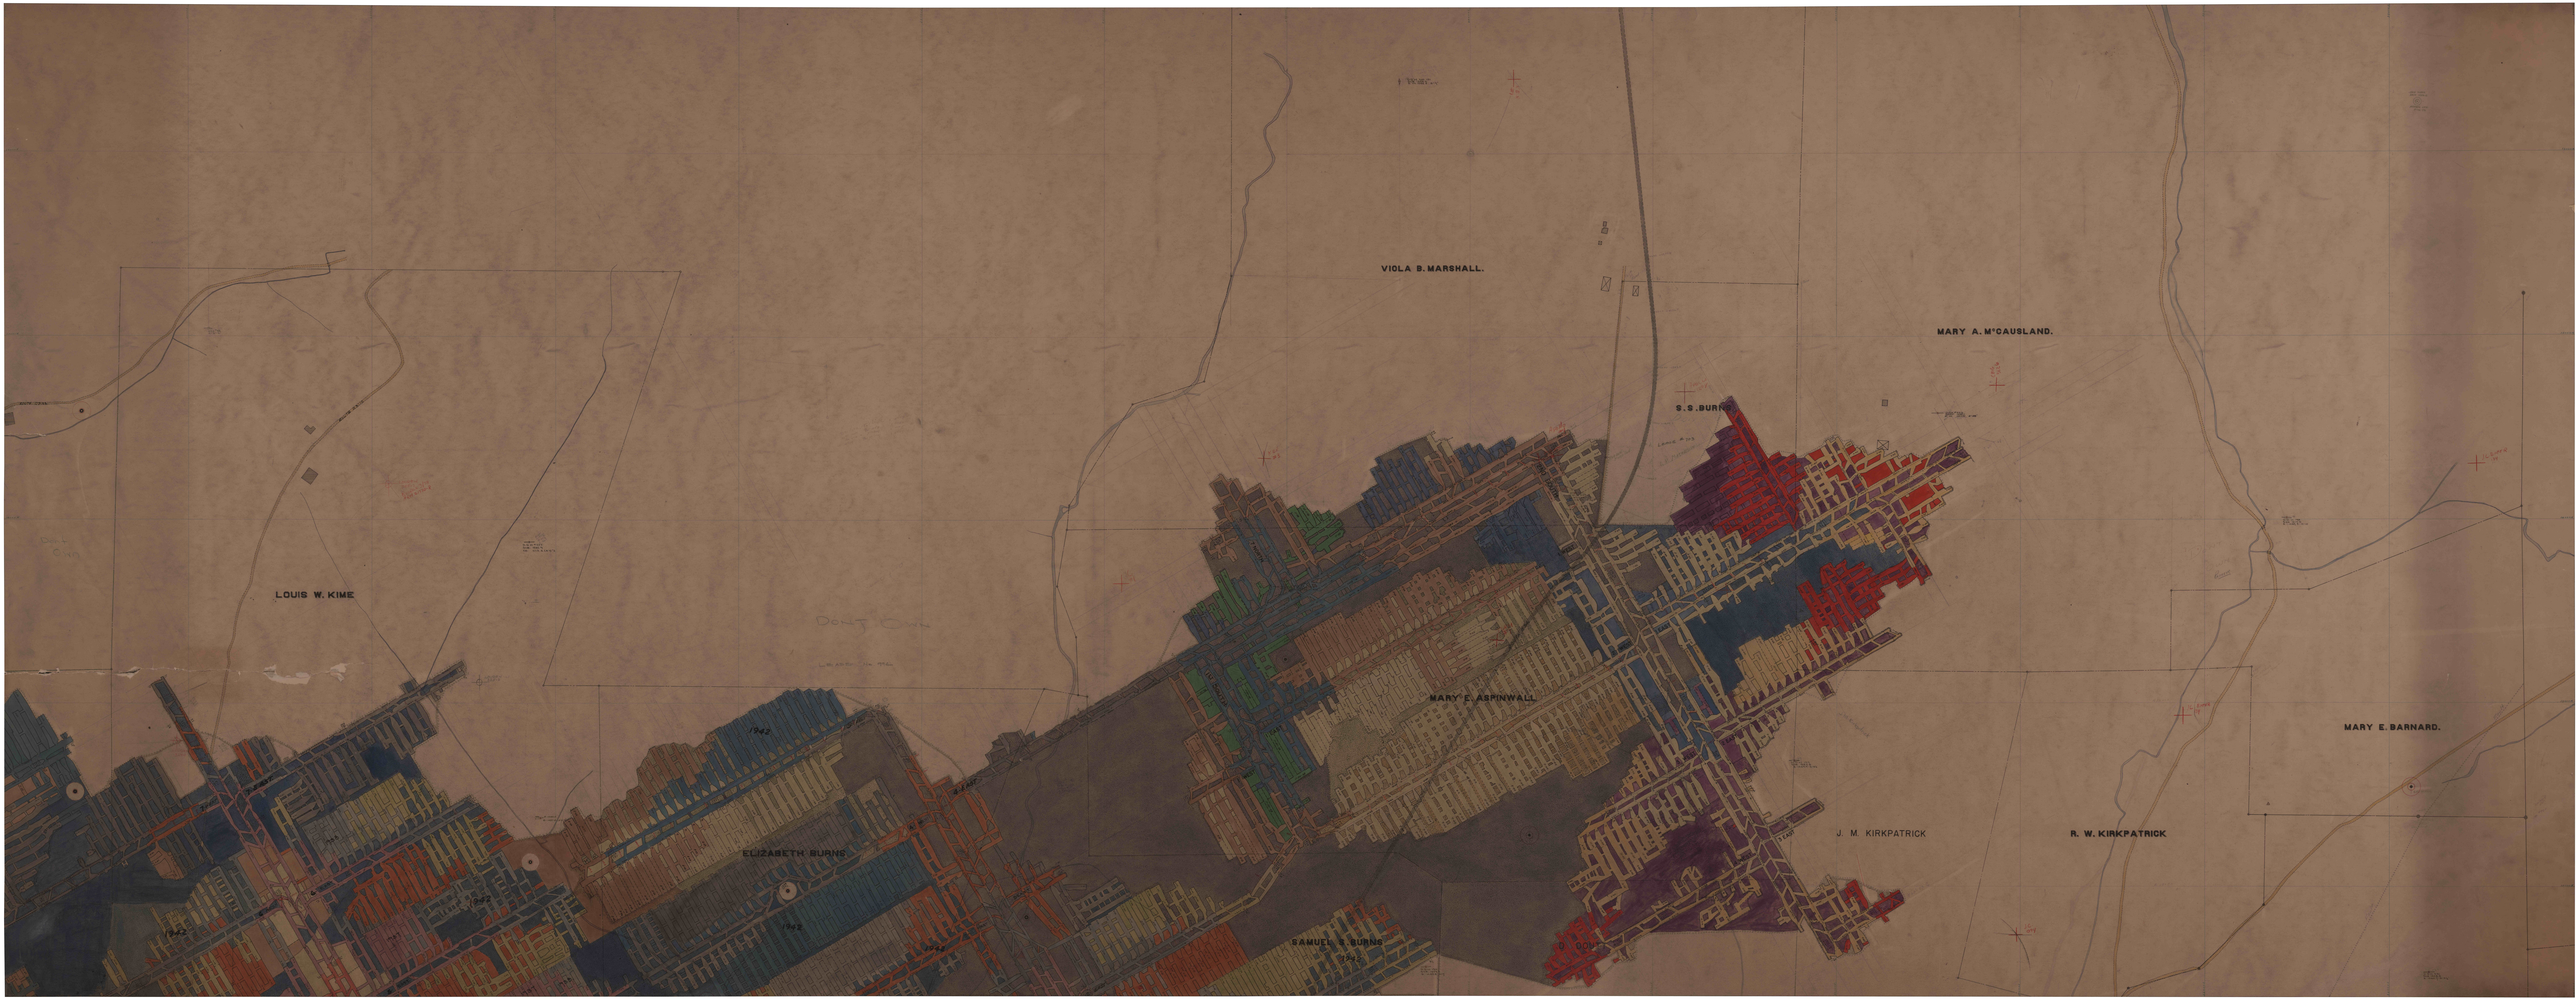
VIOLA B. MARSHALL.
MARY A. McCAUSLAND.
S. S. BURNS
LOUIS W. KIME
MARY E. ASPINWALL
MARY E. BARNARD.
ELIZABETH BURNS
J. M. KIRKPATRICK
R. W. KIRKPATRICK
SAMUEL S. BURNS
1942