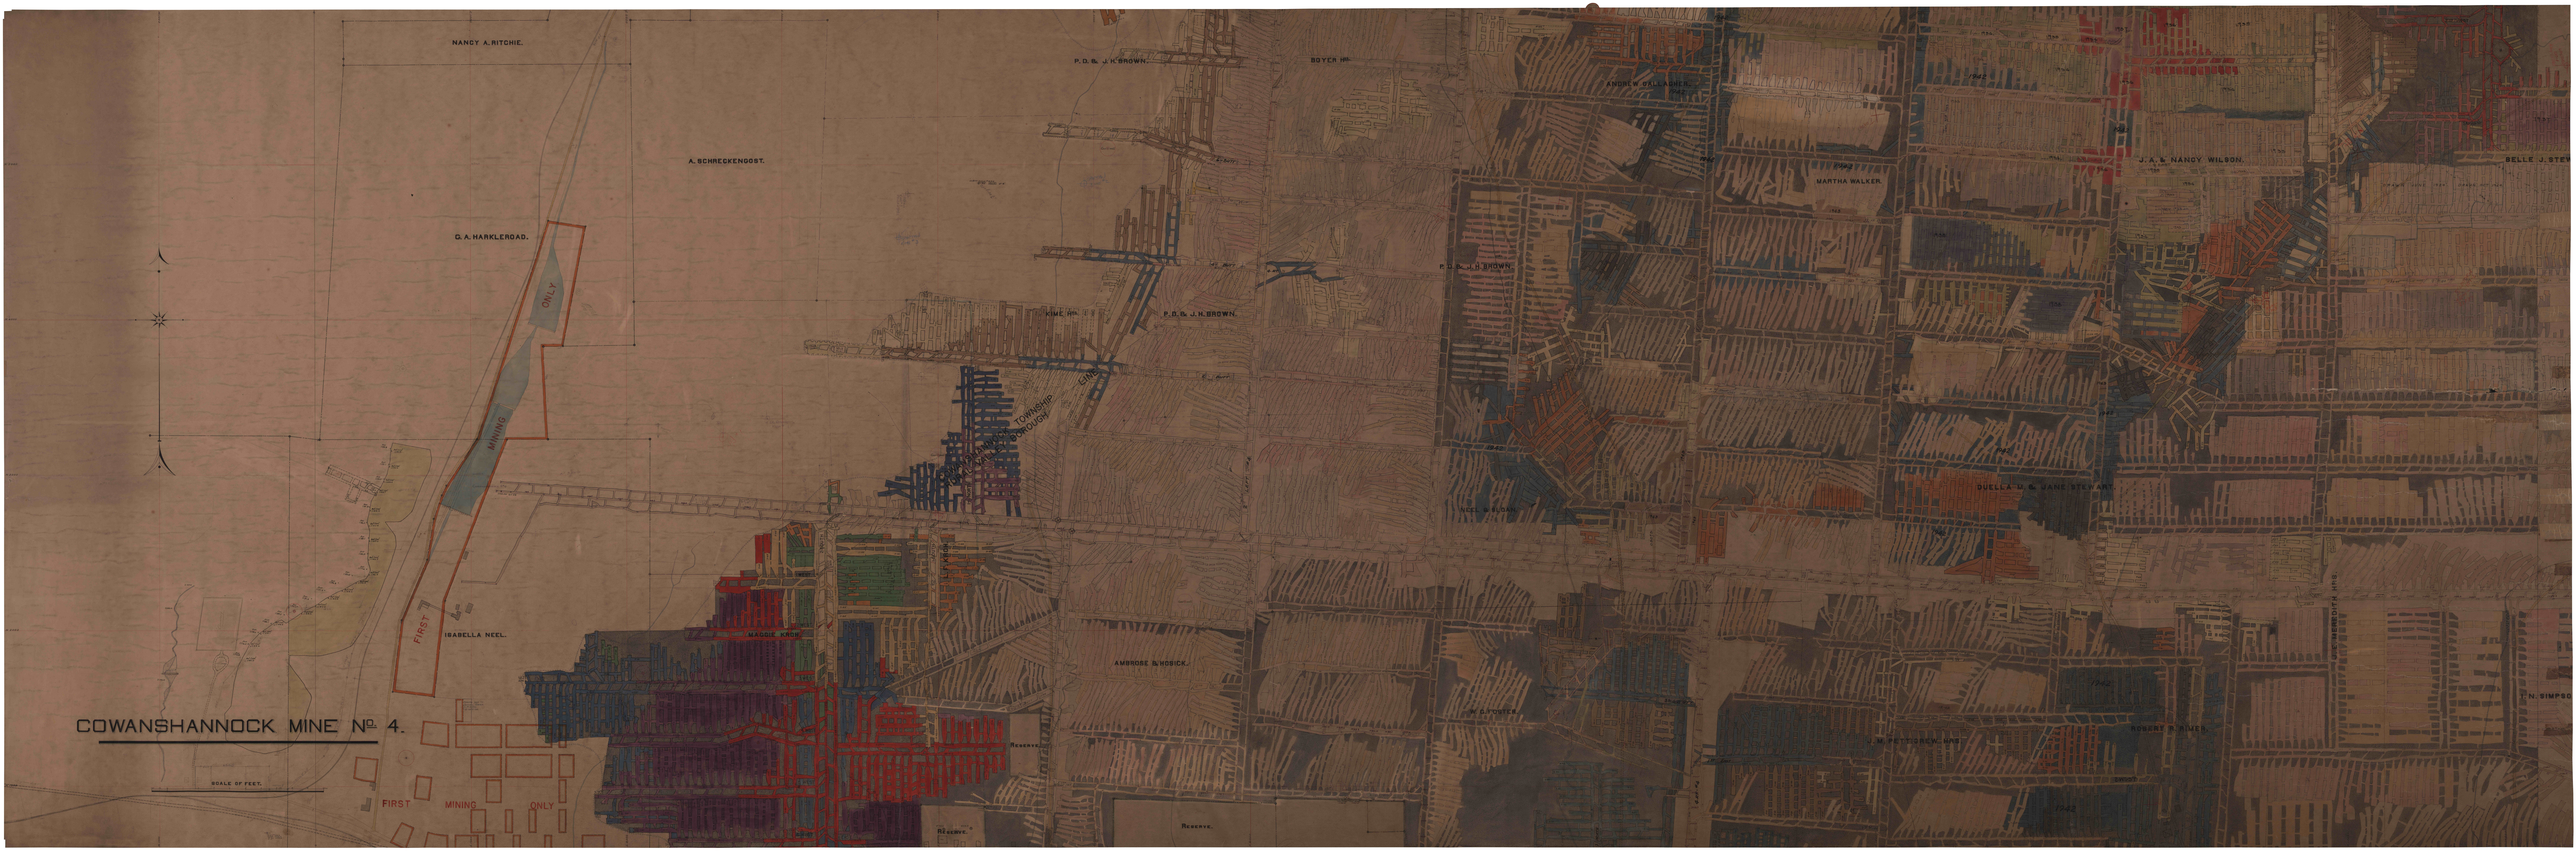

COWANSHANNOCK MINE No. 4.