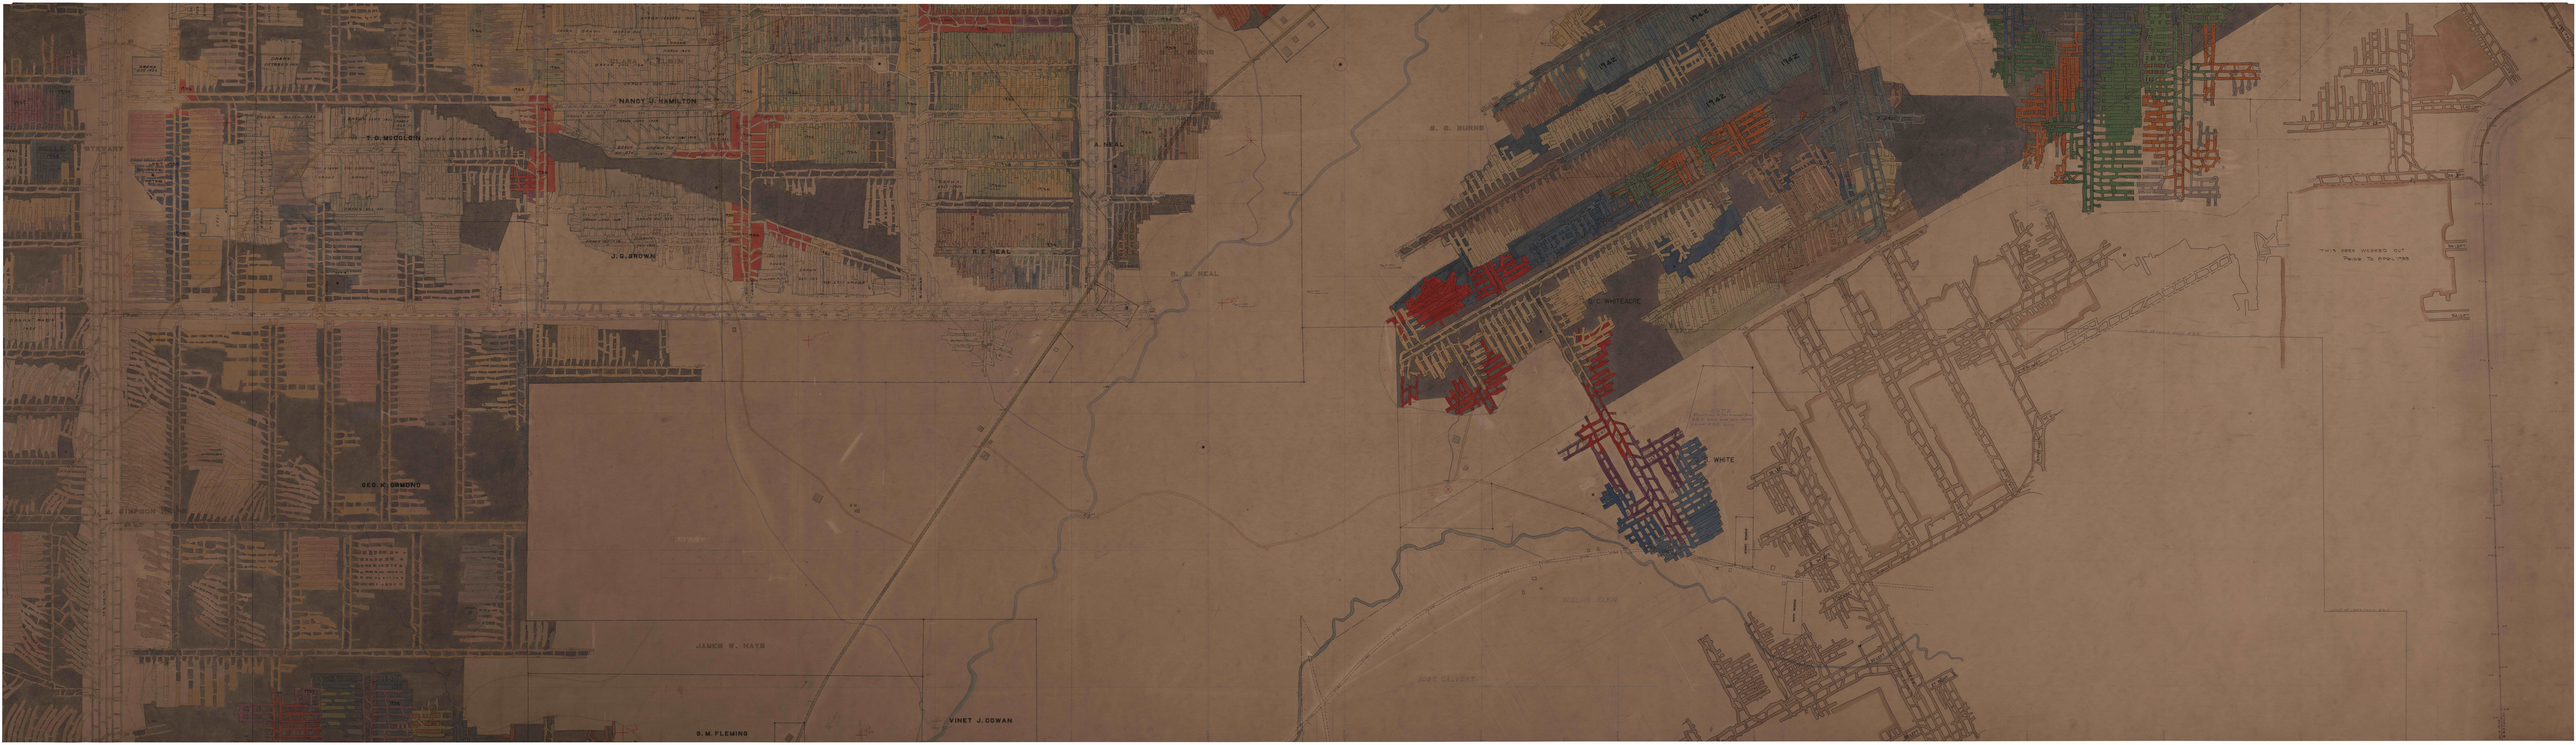
NANCY J. HAMILTON
T. O. McCOLGIN
J. G. BROWN
A. NEAL
R. E. NEAL
R. E. NEAL
S. B. BURNS
E. C. WHITEACRE
WHITE
JAMES W. HAYS
S. M. FLEMING
VINET J. COWAN
THIS AREA WORKED OUT PRIOR TO APRIL 1938