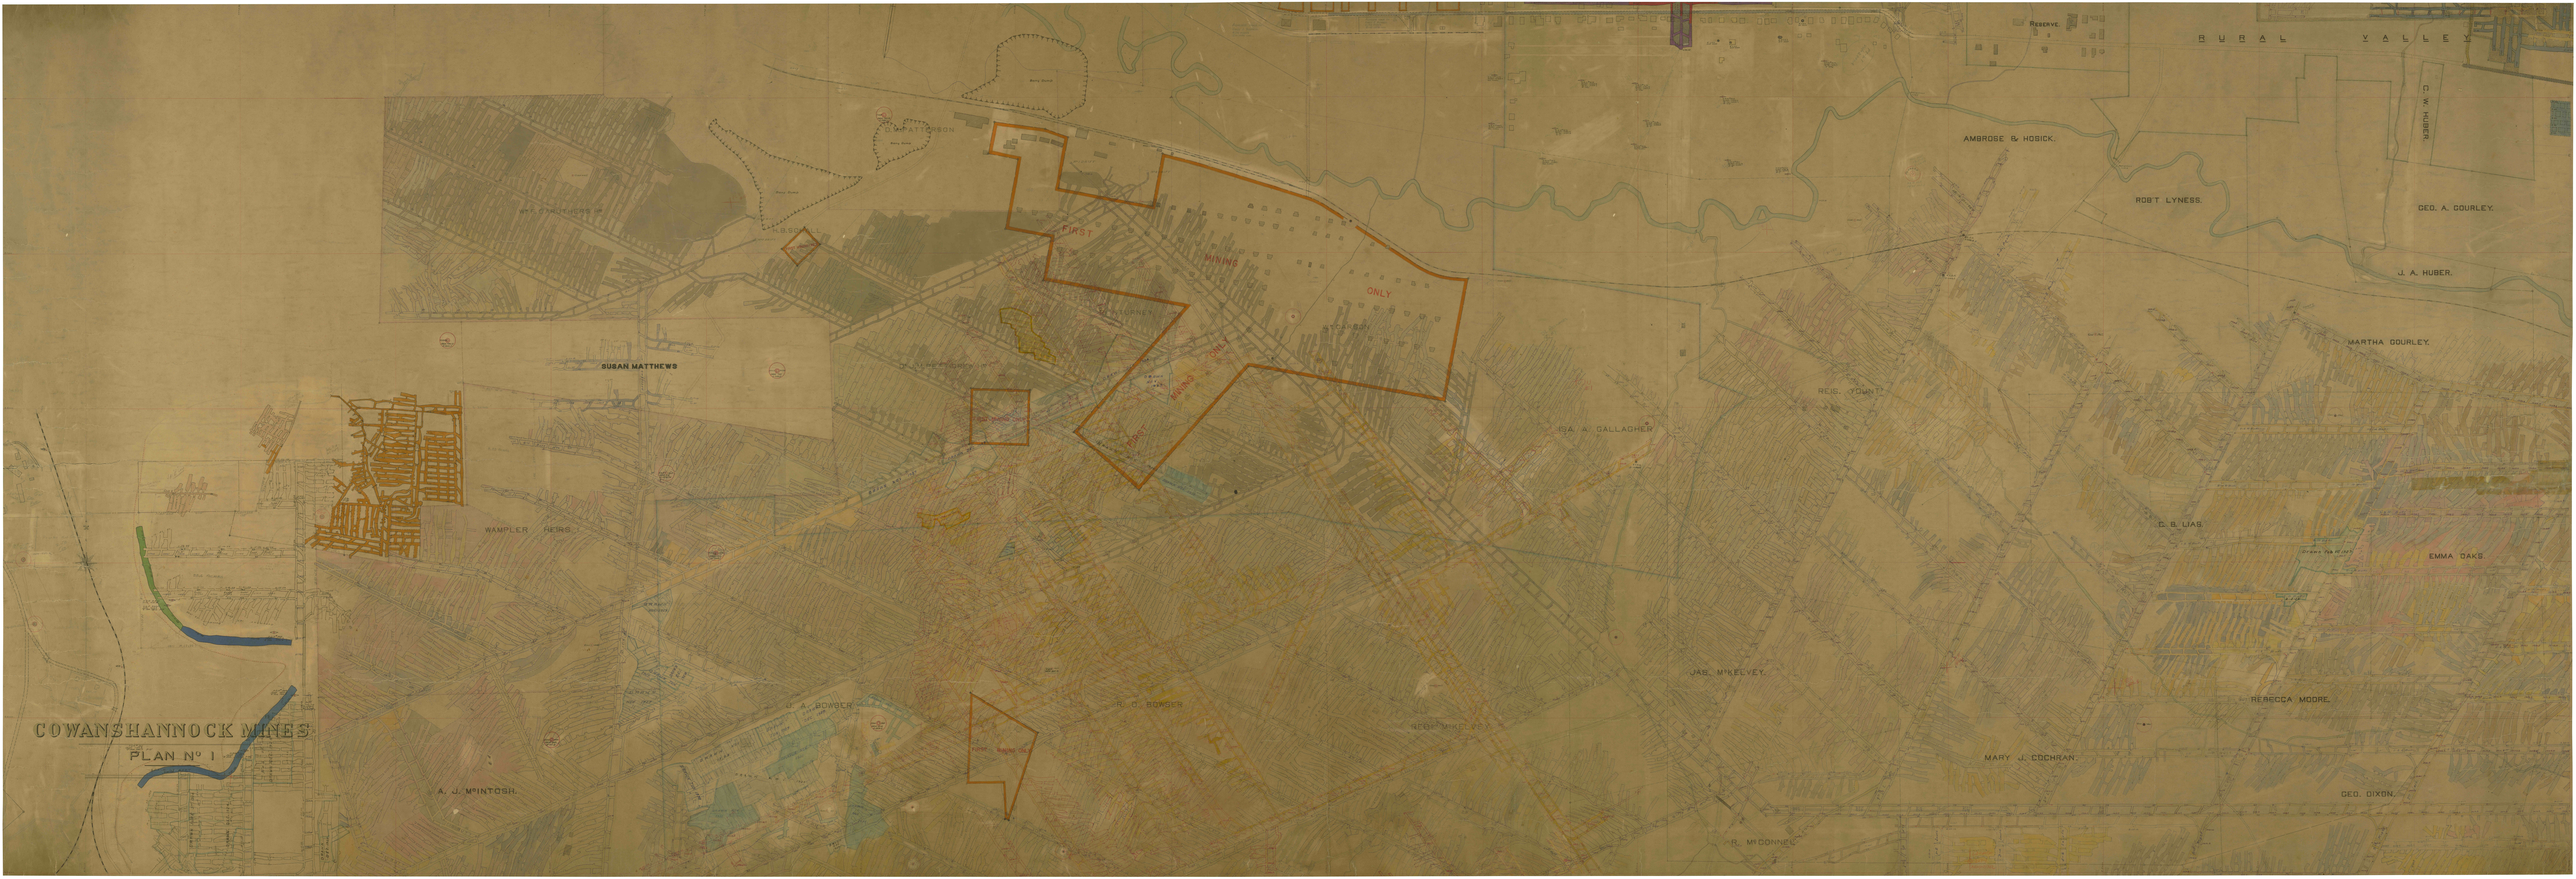
COWANSHANNOCK MINES
PLAN Nº 1
RUBAL VALLEY
RESERVE
AMBROSE & HOSICK.
ROBT LYNESS.
C. W. HUBER.
GEO. A. COURLEY.
J. A. HUBER.
MARTHA COURLEY.
REIS. YOUNT.
WM. A. GALLAGHER
C. B. LIAS.
EMMA OAKS.
REBECCA MOORE.
MARY J. COCHRAN.
GEO. DIXON.
JAS. McKELVEY.
R. McCONNELL
R. C. BOWSER
J. A. BOWSER
A. J. McINTOSH.
WAMPLER HEIRS.
SUSAN MATTHEWS
D. W. PATTERSON
FIRST
MINING
ONLY
