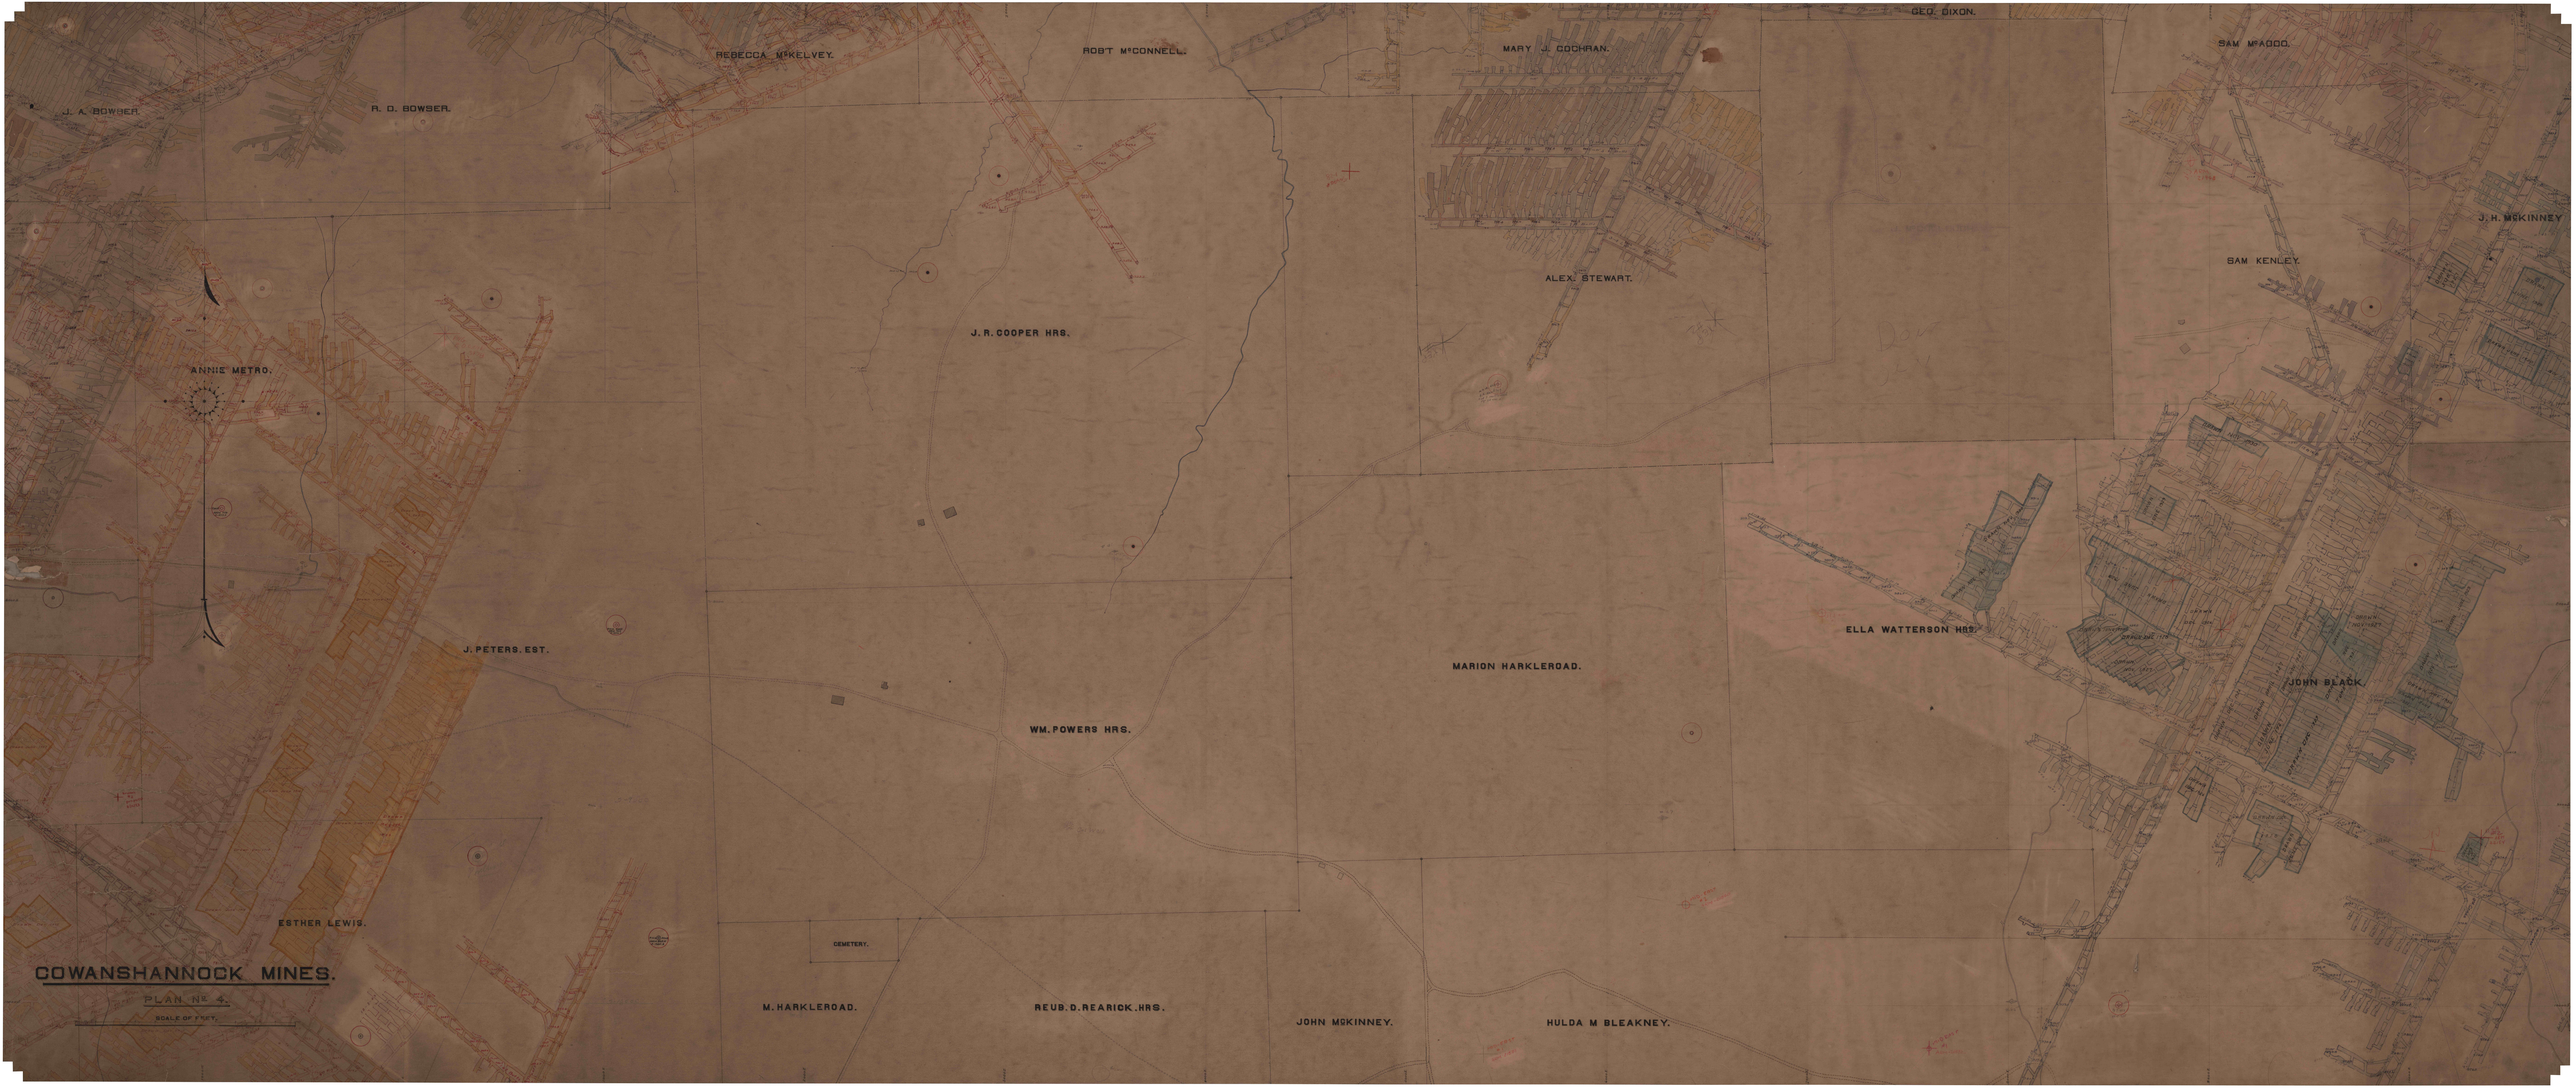
GEO. DIXON.
SAM McADOO.
REBECCA McKELVEY.
ROBT McCONNELL.
MARY J. COCHRAN.
J. A. BOWSER.
R. D. BOWSER.
J. H. McKINNEY
SAM KENLEY.
ALEX. STEWART.
J. R. COOPER HRS.
ANNIE METRO.
ELLA WATTERSON HRS.
J. PETERS. EST.
MARION HARKLEROAD.
JOHN BLACK.
WM. POWERS HRS.
ESTHER LEWIS.
CEMETERY.
M. HARKLEROAD.
REUB. D. REARICK. HRS.
JOHN McKINNEY.
HULDA M BLEAKNEY.
COWANSHANNOCK MINES.
PLAN No 4.
SCALE OF FEET.