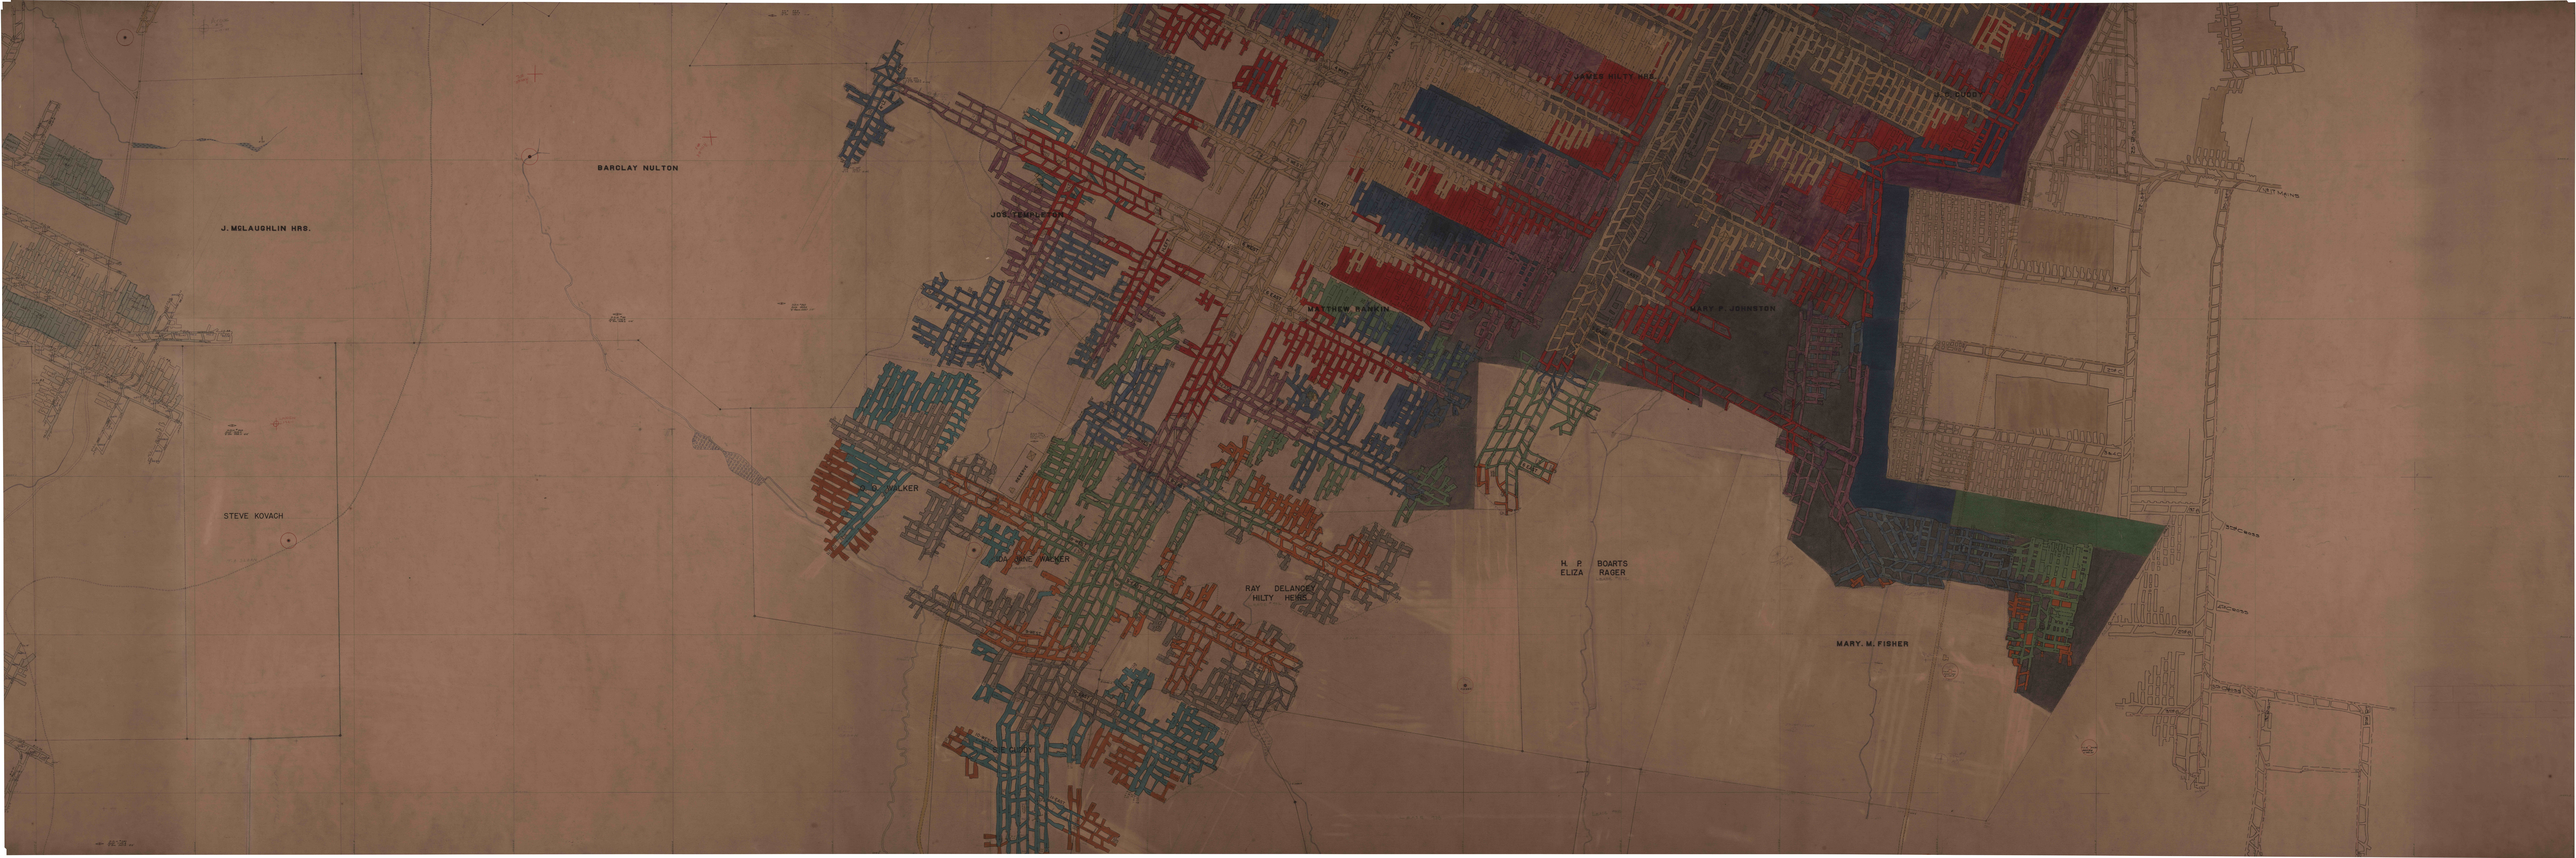
BARCLAY NULTON
J. MCLAUGHLIN HRS.
JOS. TEMPLETON
JAMES HILTY HRS.
MATTHEW RANKIN
MARY P. JOHNSTON
STEVE KOVACH
W. D. WALKER
RAY DELANCEY
HILTY HEIRS
H. P. BOARTS
ELIZA RAGER
MARY. M. FISHER