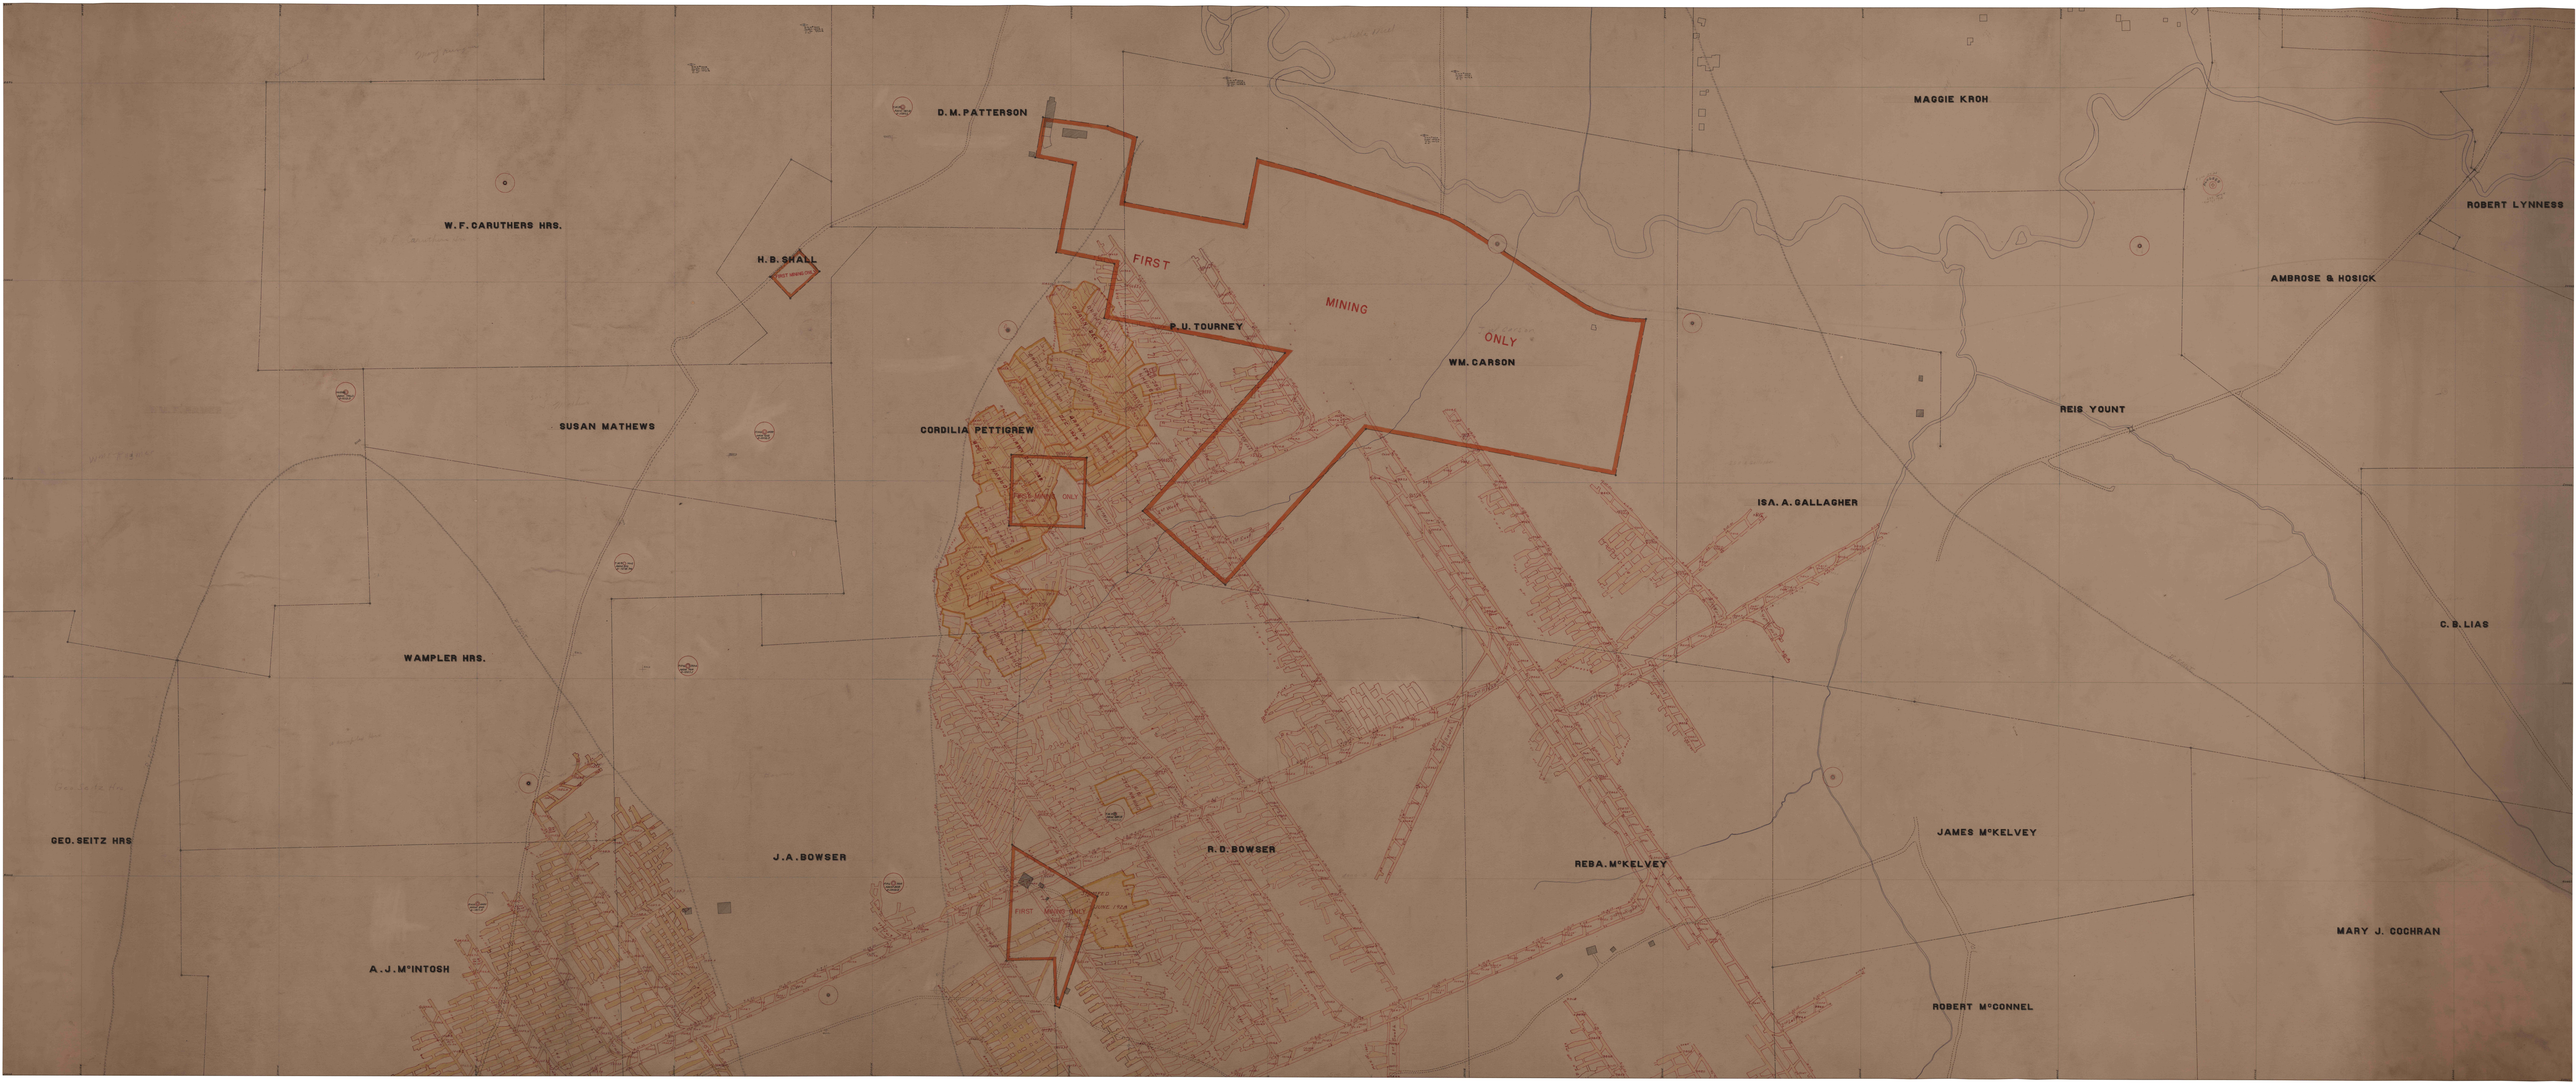
D. M. PATTERSON
MAGGIE KROH
W. F. CARUTHERS HRS.
H. B. SHALL
FIRST
MINING
ONLY
P. U. TOURNEY
WM. CARSON
ROBERT LYNNESS
AMBROSE & HOSICK
REIS YOUNT
SUSAN MATHEWS
CORDILIA PETTIGREW
ISA. A. GALLAGHER
C. B. LIAS
WAMPLER HRS.
GEO. SEITZ HRS
J. A. BOWSER
R. D. BOWSER
REBA. McKELVEY
JAMES McKELVEY
MARY J. COCHRAN
A. J. McINTOSH
ROBERT McCONNEL